

**SURVEY & REMONUMENTATION**

MAR 23 2000

**SECTION**

**REMONUMENTATION  
LAND CORNER RECORDATION CERTIFICATE  
Filing Requirement of Act 74, Mich. P.A. 1970**

RECEIVED FOR RECORD

99 DEC 14 AM 9:14

For corners in

<u>Lapeer</u> (County)	Located in: Goodland Twp.	Corner Code # <u>M-7</u>
1. Public Land Survey	T <u>8N</u> R <u>12E</u>	<u>M-7</u>
	T _____ R _____	_____
	T _____ R _____	_____
	T _____ R _____	_____
2. Property Controlling in Section	S _____ T _____ R _____	_____
	S _____ T _____ R _____	_____
3. Miscellaneous Property in Sec.	S _____ T _____ R _____	_____
	S _____ T _____ R _____	_____

*Melissa Da Vaughn*  
REGISTER OF DEEDS  
LAPPEER COUNTY, MICHIGAN

**517**

**Register of Deeds Stamp & File Number**

4. Lot No. \_\_\_\_\_, Recorded Plat \_\_\_\_\_  
5. Private Claims \_\_\_\_\_


A B C D E F G H I J K L M

1													
2	6	5	4	3	2	1							
3													
4	7	8	9	10	11	12							
5													
6	18	17	16	15	14	13							
7													
8	19	20	21	22	23	24							
9													
10	30	29	28	27	26	25							
11													
12	31	32	33	34	35	36							
13													

I, Earl E. Gravlin, in a field survey on July 22 1999, do hereby certify that under requirements of P.A. 74, Michigan P.A. of 1970, the corner points mentioned in lines 1 and 2 above were in conformance with regulations and rules therefore as required in the current manual of survey instructions of the United States Department of the Interior, Bureau of Land Management or by a decree of a Court of Law and/or that the corner points mentioned in lines 3, 4 and 5 above were in conformance with the rules of the Michigan Board of Land Surveyors or by a Decree of a Court of Law; established, re-established, monumented, re-monumented, recovered, found as expressed below:

**NOTE: Not more than 4 corners, all in the same town and range, may be recorded on this certificate.**

A. Description of original monument and accessories and/or subsequent restoration:  
GLO: 1822 Wampler, set post at 80 chains, tamarack 18 N59W 13, tamarack 9 S33W 21. County Surveyor: nothing. 1998 Gravlin L13 P58, set 1/2" iron on split between 1/4 corners 9' E of N-S road & 13' N of E-W road, N45W 54.21' nail N side 6" elm, S50W 76.58' nail N side 10" elm, E 43.42' SW cor house, N40E 65.65' NW cor house, S 72.90' NW cor sec 19 T8N-R13E. Unrecorded surveys: none. Act 74: none.

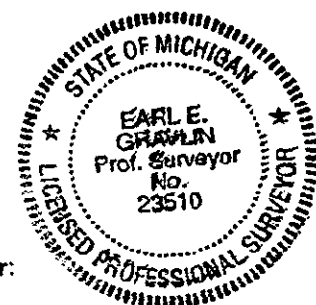

B. Description of corner evidence found and/or method applied in restoring or reestablishing corner:  
Found 1/2" iron in gravel road witnesses match L13 P58  
M-7 to M-8 2633.27'  
M-7 to L-7 2665.50'

C. Description of monument for corner and accessories established to perpetuate locating the position of the corner:  
M-7 section corner common to 13, 24 set standard brass cap on 1/2" iron  
N87E 43.34' SW corner foundation house  
N48E 65.60' NW corner foundation house  
N41W 54.20' nail and tag North side 6" elm  
S61W 76.37' nail and tag North side 10" elm  
S16W 113.69' nail and tag East side 8" elm  
S27E 67.19' nail and tag West side 18" oak

BEER GROUP  
APPROVED LAND CORNER  
PA 245 OF 1990  
LAPPEER COUNTY

*[Signature]*  
RAY DAVIS P.S. CO. SURVEYOR  
DATE 10-21-99

Signed by [Signature] Date DEC 3, 1999  
Surveyor's Michigan License No. 23510

FORM APPROVED BY MICHIGAN STATE BOARD OF LAND SURVEYORS, JAN. 28, 1971

REVISED MAY 24, 1975  
REVISED JAN. 1983  
ADAPTED FOR WORD PROCESSING MARCH, 1993