

REMONUMENTATION
LAND CORNER RECORDATION CERTIFICATE
Filing Requirement of Act 74, Mich. P.A. 1970

For corners in

<u>LAPEER</u> (County)	Located In: Goodland	Corner Code # M-10
1. Public Land Survey	T 8N R 12E T _____ T _____ T _____	_____
2. Property Controlling in Section	S _____ T _____ R _____ S _____ T _____ R _____	_____
3. Miscellaneous Property in Sec.	S _____ T _____ R _____ S _____ T _____ R _____	_____
4. Lot No. _____, Recorded Plat _____		
5. Private Claims _____		

RECEIVED FOR RECORD
94 JAN -5 PM 1:26
LIBER NO. 005 PAGE NO. 76
Melissa Miles
REGISTERED DEEDS
LAPEER COUNTY MICHIGAN
Register of Deeds Stamp & File Number

I, John C. Niederhauser, in a field survey on Nov. 4, 19 93, do hereby certify that under requirements of P.A. 74, Michigan P.A. of 1970, the corner points mentioned in lines 1 and 2 above were in conformance with regulations and rules therefore as required in the current manual of survey instructions of the United States Department of the Interior, Bureau of Land Management or by a decree of a Court of Law and/or that the corner points mentioned in lines 3, 4 and 5 above were in conformance with the rules of the Michigan Board of Land Surveyors or by a Decree of a Court of Law; established, re-established, monumented, re-monumented, recovered, found as expressed below:

	A	B	C	D	E	F	G	H	I	J	K	L	M
2	6	5	4	3	2	1							
3													
4	7	8	9	10	11	12							
5													
6	18	17	16	15	14	13							
7													
8	19	20	21	22	23	24							
9													
10	30	29	28	27	26	25							
11													
12	31	32	33	34	35	36							
13													

NOTE: Not more than 4 corners, all in the same town and range, may be recorded on this certificate.

A. Description of original monument and accessories and/or subsequent restoration:


Post (G.L.O. Notes) Set Post 40 ch north of SE corner Section 25 (pg. 594)

B. Description of corner evidence found and/or method applied in restoring or reestablishing corner:

1/2" rod bent south Referred to in 1971 Road Commission note
2673.24' South to NW corner Section 36

C. Description of monument for corner and accessories established to perpetuate locating the position of the corner:

- Set brass disk stamped "Lapeer County Remonumentation M-10 #24608
- NNW to nail w/remon. tag NE side 8" elm 40.55'
- NW to nail w/remon. tag N side twin 8" elm 30.35'
- West to nail w/remon. tag N side 8" elm 26.60'
- ESE to nail w/remon. tag N side 6" elm 27.08'
- NE to nail w/ remon. tag SE side 6" elm 25.62'
- NW to nail w/remon. tag N side 6" ash 20.06'
- SW to nail w/remon. tag E side twin 6" oak 30.10'

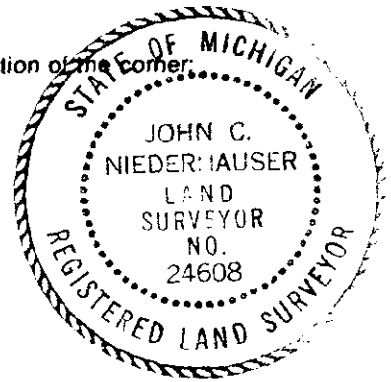

Signed by *John C. Niederhauser* Date Dec. 30, 1993
Surveyor's Michigan License No. 24608