

SURVEY & REMONUMENTATION

MAR 23 2000

REMONUMENTATION

RECEIVED FOR RECORD

LAND CORNER RECORDATION CERTIFICATE

00 FEB 10 PM 2: 20

SECTION

Filing Requirement of Act 74, Mich. P.A. 1970

Melissa DeVaugh
REGISTER OF DEEDS
LAPEER COUNTY, MICHIGAN

For corners in

LAPEER
(County)

Located in:
MARATHON TWP.


Corner Code #

1. Public Land Survey T 9 N R 9 E K-13
2. Property Controlling in Section S T R
3. Miscellaneous Property in Sec. S T R

4. Lot No. Recorded Plat
5. Private Claims

495

Register of Deeds Stamp & File Number

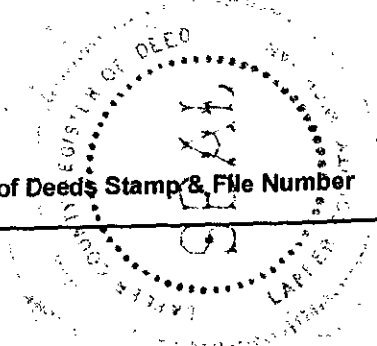

I, MICHAEL G. HAY, in a field survey on AUGUST 22, 1999, do hereby certify that under requirements of P.A. 74, Michigan P.A. of 1970, the corner points mentioned in lines 1 and 2 above were in conformance with regulations and rules therefore as required in the current manual of survey instructions of the United States Department of the Interior, Bureau of Land Management or by a decree of a Court of Law and/or that the corner points mentioned in lines 3, 4 and 5 above were in conformance with the rules of the Michigan Board of Land Surveyors or by a Decree of a Court of Law; established, re-established, monumented, re-monumented, recovered, found as expressed below:

NOTE: Not more than 4 corners, all in the same town and range, may be recorded on this certificate.

	A	B	C	D	E	F	G	H	I	J	K	L	M
1													
2	6	5	4	3	2	1							
3													
4	7	8	9	10	11	12							
5													
6	18	17	16	15	14	13							
7													
8	19	20	21	22	23	24							
9													
10	30	29	28	27	26	25							
11													
12	31	32	33	34	35	36							
13													


- A. Description of original monument and accessories and/or subsequent restoration:
- 1821- JOSEPH WAMPLER D.S. SET POST CORNER SECTIONS 35 AND 36
 - 1971- BERNARD HENDERSON P.S.16043 (SURVEY) LIBER 1 PAGE 17 FOUND "T" IRON
 - 1975- ROBERT G. KAY P.S. 14096 (SURVEY) LIBER 3 PAGES 356-357 FOUND "T" IRON
 - 1975- HAROLD N. ELRICH P.S. 18986 (SURVEY) LIBER 3 PAGE 456 FOUND T-IRON
 - 1975- HAROLD N. ELRICH P.S. 18986 (LCRC) LIBER 4 PAGE 139 FOUND T-IRON
 - 1976- HAROLD N. ELRICH P.S. 18986 (SURVEY) LIBER 3 PAGE 600 FOUND T-IRON
 - 1977- HAROLD N. ELRICH P.S. 18986 (SURVEY) LIBER 4 PAGE 263 FOUND T-IRON
 - 1977- HAROLD N. ELRICH P.S. 18986 (SURVEY) LIBER 4 PAGE 262 FOUND T-IRON
 - 1977- HAROLD N. ELRICH P.S. 18986 (SURVEY) LIBER 4 PAGES 295-296 FOUND T-IRON
 - 1987- EARL E. GRAVLIN P.S. 23510 (SURVEY) LIBER 007 PAGE 742 FOUND "T" IRON
 - 1997- MICHAEL G. HAY P.S. 41101 (SURVEY) LIBER 0012 PAGES 0179-0180 FOUND "T" IRON
 - 1997- RAY D. DAVIS P.S. 22430 (NOT RECORDED) FOUND "T" IRON
 - 1998- RAY D. DAVIS P.S. 22430 (LCRC) LIBER 0006 PAGE 124 FOUND "T" IRON

PEER GROUP
APPROVED LAND CORNER
PA 345 OF 1990
LAPEER COUNTY

Ray D. Davis
RAY DAVIS P.S. CO. SURVEYOR
DATE 11-10-1999

- B. Description of corner evidence found and/or method applied in restoring or reestablishing corner:
- 1999-MICHAEL G.HAY P.S. 41101 FOUND T-IRON IN THE CENTERLINE OF NORWAY LAKE ROAD (GRAVEL) AND FLINT ROAD (GRAVEL). FENCE-TREE LINE RUNNING WEST
 - K-13 TO K-1 2.03' (M) WEST
 - K-13 TO J-13 2644.22' (HBE) 2640.00' (40 GLO)
 - K-13 TO L-13 2607.58' (M) 2610.15' (KAY) 2640.00' (40 GLO)

- C. Description of monument for corner and accessories established to perpetuate locating the position of the corner:
- SET STANDARD REMONUMENTATION CAP ON 1/2" IRON
 - N60E 64.38' PK NAIL IN S. FACE OF 14" OAK
 - S05E 114.38' NAIL IN W FACE OF 18" HICKORY
 - S60W 32.46' NAIL AND BOTTLE CAP N FACE OF 13" HICKORY
 - N25W 49.88' NAIL IN E FACE TWIN 9" ELM
 - S45W 41.66' NAIL IN TOP TEL/RISER POST

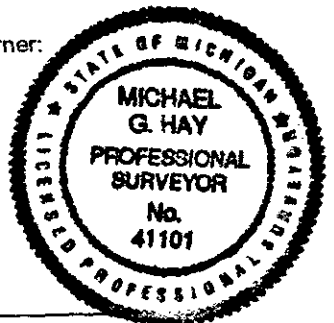

Signed by Michael G. Hay Date 1-11-2000

Surveyor's Michigan License No. 41101

FORM APPROVED BY MICHIGAN STATE BOARD OF LAND SURVEYORS, JAN. 28, 1971

REVISED MAY 14, 1975
REVISED JAN., 1983
ADAPTED FOR WORD PROCESSING MARCH, 1993