

**SURVEY & REMONUMENTATION**

**REMONUMENTATION**

RECEIVED FOR RECORD

MAR 23 2000 LAND CORNER RECORDATION CERTIFICATE

00 FEB 10 PM 2:20

Filing Requirement of Act 74, Mich. P.A. 1970

**SECTION**


For corners in

LAPEER Located In: MARATHON TWP Corner Code # \_\_\_\_\_  
 (County) MARATHON TWP

1. Public Land Survey T 9 N R 9 E L-13  
 T \_\_\_\_\_ R \_\_\_\_\_  
 T \_\_\_\_\_ R \_\_\_\_\_  
 T \_\_\_\_\_ R \_\_\_\_\_

2. Property Controlling S \_\_\_\_\_ T \_\_\_\_\_ R \_\_\_\_\_  
 in Section S \_\_\_\_\_ T \_\_\_\_\_ R \_\_\_\_\_

3. Miscellaneous S \_\_\_\_\_ T \_\_\_\_\_ R \_\_\_\_\_  
 Property in Sec. S \_\_\_\_\_ T \_\_\_\_\_ R \_\_\_\_\_

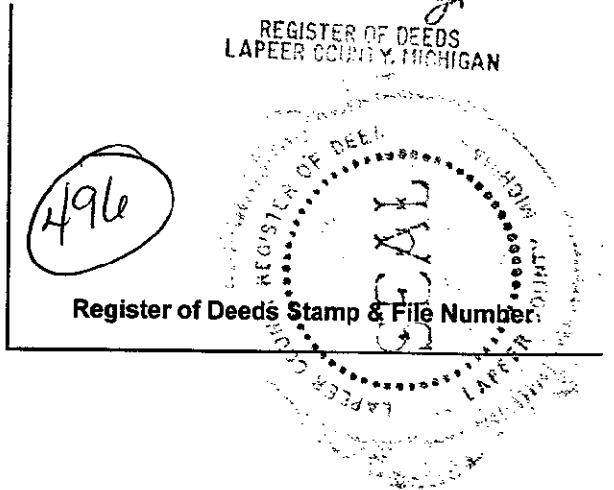

4. Lot No. \_\_\_\_\_, Recorded Plat \_\_\_\_\_  
 5. Private Claims \_\_\_\_\_

	A	B	C	D	E	F	G	H	I	J	K	L	M
1													
2	6	5	4	3	2	1							
3													
4	7	8	9	10	11	12							
5													
6	18	17	16	15	14	13							
7													
8	19	20	21	22	23	24							
9													
10	30	29	28	27	26	25							
11													
12	31	32	33	34	35	36							
13													

I, MICHAEL G. HAY, in a field survey on AUGUST 22, 19 99, do hereby certify that under requirements of P.A. 74, Michigan P.A. of 1970, the corner points mentioned in lines 1 and 2 above were in conformance with regulations and rules therefore as required in the current manual of survey instructions of the United States Department of the Interior, Bureau of Land Management or by a decree of a Court of Law and/or that the corner points mentioned in lines 3, 4 and 5 above were in conformance with the rules of the Michigan Board of Land Surveyors or by a Decree of a Court of Law; established, re-established, monumented, re-monumented, recovered, found as expressed below:

**NOTE: Not more than 4 corners, all in the same town and range, may be recorded on this certificate.**

- A. Description of original monument and accessories and/or subsequent restoration:  
 1821- JOSEPH WAMPLER D.S. SET QUARTER SECTION POST  
 1975- ROBERT G. KAY P.S. 14096 (SURVEY) LIBER 3 PAGES 356-357 FOUND 1/2" IRON  
 1977- LELAND D. BATES P.S. 16699 (SURVEY) LIBER 4 PAGES 408-409 NO DESCRIPTION  
 1987- EARL E. GRAVLIN P.S. 23510 (SURVEY) LIBER 7 PAGE 742 FOUND 1/2" IRON  
 1997- MICHAEL G. HAY P.S. 41101 (SURVEY) LIBER 12 PAGE 179 FOUND 1/2" IRON

PEER GROUP  
 APPROVED LAND CORNER  
 PA 345 OF 1990  
 LAPEER COUNTY  
Ray Davis  
 RAY DAVIS P.S. CO. SURVEYOR  
 DATE 1-10-1999

- B. Description of corner evidence found and/or method applied in restoring or reestablishing corner:  
 1999-MICHAEL G. HAY P.S. 41101 FOUND 1/2" IRON IN CENTERLINE OF FLINT RIVER ROAD (GRAVEL). NO OCCUPATION NORTH OR SOUTH.
- |              |                |                 |                   |
|--------------|----------------|-----------------|-------------------|
| L-13 TO M-13 | 2639.78' (M)   | 2640.28' (HBE)  | 2640.00' (40 GLO) |
| L-13 TO K-13 | 2607.58' (M)   | 2610.15' (KAY)  | 2640.00' (40 GLO) |
| L-13 TO L-1  | 2.89' (M) WEST | 18.48' (28 GLO) |                   |

- C. Description of monument for corner and accessories established to perpetuate locating the position of the corner:  
 SET STANDARD REMONUMENTATION CAP ON 1/2" IRON  
 N 10 E 31.19' NAIL IN TOP OF 9"x5 1/2" R.R. TIE POST  
 S 70 W 49.49' PK NAIL IN N FACE 13" PINE  
 SOUTH 31.53' PK NAIL IN W FACE 8" POPLAR  
 N 65 W 48.89' PK NAIL IN SW FACE 12" ELM



Signed by Michael G. Hay Date 1-11-2000  
 Surveyor's Michigan License No. 41101