

SURVEY &  
REMONUMENTATION

MAY 28 1997

COMMISSION

LAND CORNER RECORDATION CERTIFICATE

Filing Requirement of Act 74, Mich. P.A. 1970

RECEIVED FOR RECORD

96 DEC 27 PM 1:18

*Helen DeVaugh*  
REGISTER OF DEEDS  
LAPEER COUNTY MICHIGAN

Register of Deeds Stamp & File Number

For corners in MARATHON TWP.

LAPEER Located In: Corner Code #  
(County)

1. Public Land Survey T 09N R 09E M-2  
T \_\_\_\_\_ R \_\_\_\_\_  
T \_\_\_\_\_ R \_\_\_\_\_  
T \_\_\_\_\_ R \_\_\_\_\_
2. Property Controlling S \_\_\_\_\_ T \_\_\_\_\_ R \_\_\_\_\_  
in Section S \_\_\_\_\_ T \_\_\_\_\_ R \_\_\_\_\_
3. Miscellaneous S \_\_\_\_\_ T \_\_\_\_\_ R \_\_\_\_\_  
Property in Sec. S \_\_\_\_\_ T \_\_\_\_\_ R \_\_\_\_\_
4. Lot No. \_\_\_\_\_, Recorded Plat \_\_\_\_\_
5. Private Claims \_\_\_\_\_

I, JONATHAN M. FIELD, in a field survey on AUGUST 19 96, do hereby certify that under requirements of P.A. 74, Michigan P.A. of 1970, the corner points mentioned in lines 1 and 2 above were in conformance with regulations and rules therefore as required in the current manual of survey instructions of the United States Department of the Interior, Bureau of Land Management or by a decree of a Court of Law and/or that the corner points mentioned in lines 3, 4 and 5 above were in conformance with the rules of the Michigan Board of Land Surveyors or by a Decree of a Court of Law; established, re-established, monumented, re-monumented, recovered, found as expressed below:

NOTE: Not more than 4 corners, all in the same town and range, may be recorded on this certificate.

A. Description of original monument and accessories and/or subsequent restoration:

1833 GLO; WAMPLER, D.S.; SET 1/2 MILE POST; BEECH 12 N27W 34 1/2 LKS., BEECH 10 S31W 37LKS. 1985 ELRICH, P.S.#18986; SURVEY L.007, PG.057; FND IRON BAR; N75W 75.83' SPIKE 20" WALNUT, N20W 60.02' SPIKE 20" WALNUT, S20E 53.55' SPIKE 24" OAK, S45W 40.47' ROAD SIGN

	A	B	C	D	E	F	G	H	I	J	K	L	M
1													
2	6	5	4	3	2	1							
3													
4	7	8	9	10	11	12							
5													
6	18	17	16	15	14	13							
7													
8	19	20	21	22	23	24							
9													
10	30	29	28	27	26	25							
11													
12	31	32	33	34	35	36							
13													

PEER GROUP  
APPROVED LAND CORNER  
PA 345 OF 1990  
LAPEER COUNTY

*Ray Davis*  
RAY DAVIS P.S. CO. SURVEYOR

DATE 8-27-96

B. Description of corner evidence found and/or method applied in restoring or reestablishing corner:

1996 ROWE ENG.; FIELD, P.S.#37276; FND. POINTED STONE WITH 1/2" ROD AND 1/4" X 1 1/2" BAR BOTH LEANING OVER STONE; 3' E. OF C/L WILLITS ROAD N-S & ON C/L BRIGGS ROAD TO W. HELD HIGH POINT OF POINTED STONE. ALSO RECOVERED ALL 4 1985 WITNESSES CITED ABOVE & INDICATING THAT FND STONE, ROD, & BAR ARE IN SAME POSITION AS 1985 BAR CITED ABOVE

M-2 TO M-1 3775.06'

M-2 TO M-3 2637.50'


ACCEPTED FND. STONE AS BEST EVIDENCE OF ORIGINAL CORNER POSITION.

C. Description of monument for corner and accessories established to perpetuate locating the position of the corner:

M-2 REPLACED STONE W/ 1/2" ROD & STANDARD REMON CAP  
N75°W, 75.84' SET NAIL W/TAG #37276 IN S. FACE 24" WALNUT  
N20°W, 59.97' SET NAIL W/TAG #37276 IN E. FACE 24" WALNUT  
S20°E 53.53' SET NAIL W/TAG #37276 ABOVE FND NAIL IN SW FACE 30" OAK  
S45°W, 40.47' ROAD SIGN POST  
N25°E, 74.59' SET NAIL W/TAG #37276 IN SE FACE 8" MAPLE

Signed by *Jonathan M. Field* Date 12-2-96

Surveyor's Michigan License No. 37276

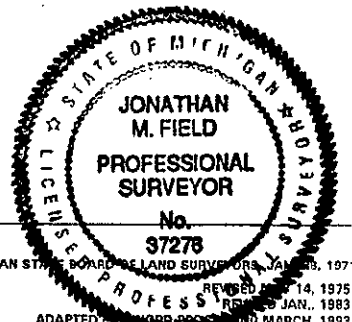

FORM APPROVED BY MICHIGAN STATE BOARD OF LAND SURVEYORS, JAN. 25, 1971  
REVISED JAN. 14, 1975  
REVISED JAN. 1983  
ADAPTED FROM BOARD BOOK, MARCH, 1993