

SURVEY & REMONUMENTATION

APR 29 1996

COMMISSION

LAND CORNER RECORDATION CERTIFICATE

Filing Requirement of Act 74, Mich. P.A. 1970
1995 REMONUMENTATION PROGRAM

RECEIVED FOR RECORD

95 DEC 13 AM 8:51

LIBER NO. 5 FILE NO. 312
Helen S. Smith
REGISTER OF DEEDS
LAPEER COUNTY, MICHIGAN

For corners in MARATHON TWP.

<u>LAPEER</u>	Located In:	Corner Code #
(County)		
1. Public Land Survey	T <u>09N</u> R <u>09E</u>	<u>M-3</u>
	T _____ R _____	_____
	T _____ R _____	_____
	T _____ R _____	_____
2. Property Controlling in Section	S _____ T _____ R _____	_____
	S _____ T _____ R _____	_____
3. Miscellaneous Property in Sec.	S _____ T _____ R _____	_____
	S _____ T _____ R _____	_____

Register of Deeds Stamp & File Number

4. Lot No. _____, Recorded Plat _____
5. Private Claims _____

I, JONATHAN M. FIELD, in a field survey on MARCH 19 95, do hereby certify that under requirements of P.A. 74, Michigan P.A. of 1970, the corner points mentioned in lines 1 and 2 above were in conformance with regulations and rules therefore as required in the current manual of survey instructions of the United States Department of the Interior, Bureau of Land Management or by a decree of a Court of Law and/or that the corner points mentioned in lines 3, 4 and 5 above were in conformance with the rules of the Michigan Board of Land Surveyors or by a Decree of a Court of Law; established, re-established, monumented, re-monumented, recovered, found as expressed below:

1	A	B	C	D	E	F	G	H	I	J	K	L	M
2	6	5	4	3	2	1							
3													
4	7	8	9	10	11	12							
5													
6	18	17	16	15	14	13							
7													
8	19	20	21	22	23	24							
9													
10	30	29	28	27	26	25							
11													
12	31	32	33	34	35	36							
13													

NOTE: Not more than 4 corners, all in the same town and range, may be recorded on this certificate.

A. Description of original monument and accessories and/or subsequent restoration:

- 1852 GLO; WAMPLER, D.S.; SET POST; LINDEN 5 N12 1/2W 6LKS., ASH 11 S57W 4LKS.
- 1906 SICKLESTEEL, C.S.; SURVEY OF SEC.12; STAKE; BURR OAK 2 1/2 N63W 64LKS.
- 1979 BECK-GRAVLIN; BECK, P.S.#21559; SURVEY L.5, PG.596-599; FND 3/4" IRON IN MON BOX; N30W 22.74' E. LEG BRIDGE SIGN, S45W 17.50' BRIDGE WT. LIMIT SIGN, N20E 60.50' STOP SIGN

B. Description of corner evidence found and/or method applied in restoring or reestablishing corner:

- 1995 ROWE ENG.; FIELD, P.S.#37276; FND 3/4" PIPE IN MON. BOX 3.5'W. OF C/L GRAVEL ROAD N-S 2'S. OF C/L EXTENDED OF OTTER LAKE RD TO W. (ASPH.)

G.L.O. NOTES FOR T9N-R10E INDICATE THAT THIS CORNER IS NOT COMMON WITH A 3/4" T9N-R10E


PEER GROUP
APPROVED LAND CORNER
LAPEER COUNTY
[Signature]
RAY DAVIS P.S. CO. SURVEYOR
DATE 7-13-95

M-3 TO M-4 2632.60' (BECK 1979)

ACCEPTED FND PIPE AS A CAREFUL AND FAITHFUL PERPETUATION OF THE ORIGINAL CORNER POSITION

C. Description of monument for corner and accessories established to perpetuate locating the position of the corner:

- M-3 SET 1/2"X 18" ROD W/ STANDARD BRASS CAP INSIDE 3/4" PIPE
- N70°E, 26.13' SET CHIS. NOTCH IN TOP N. END 18" CMP
- S30°E, 56.82' SET NAIL W/REMON TAG IN NE FACE 12" OAK
- S45°W, 74.57' SET P-K NAIL W/RAMON TAG IN NW FACE P. POLE
- N80°W, 28.76' SET P-K NAIL W/REMON TAG IN S. FACE P. POLE
- N20°E, 60.5' STOP SIGN POST

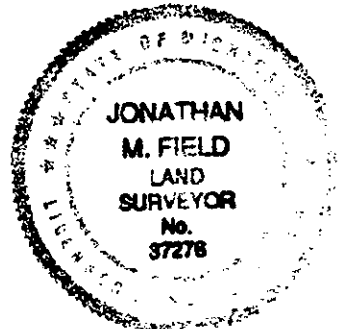

Signed by *Jonathan M. Field* Date 12-1-95
Surveyor's Michigan License No. 37276