

1993

COMMISSION

REMONUMENTATION LAND CORNER RECORDATION CERTIFICATE

Filing Requirement of Act 74, Mich. P.A. 1970 RECEIVED FOR RECORD

For corners in

Form with fields for LAPEER (County), Located In: T 9 N R 9 E, Corner Code # M-10, and numbered sections 1-5 for survey details.

Stamp area containing date 94 JAN -6 PM 12:49, LIBER NO 005, FILE NO 57, and signature of Melissa Miles, REGISTER OF DEEDS, LAPEER, MICHIGAN. Includes 'Register of Deeds Stamp & File Number' text.

Jonathan M. Field, in a field survey on October, 1993, do hereby certify that under requirements of P.A. 74, Michigan P.A. of 1970, the corner points mentioned in lines 1 and 2 above were in conformance with regulations and rules therefore as required in the current manual of survey instructions of the United States Department of the Interior, Bureau of Land Management or by a decree of a Court of Law and/or that the corner points mentioned in lines 3, 4 and 5 above were in conformance with the rules of the Michigan Board of Land Surveyors or by a Decree of a Court of Law; established, re-established, monumented, re-monumented, recovered, found as expressed below:

Grid table with columns A-M and rows 2-13, containing numbers 1-36.

NOTE: Not more than 4 corners, all in the same town and range, may be recorded on this certificate.

- A. Description of original monument and accessories and/or subsequent restoration: 1822 GLO- Wampler, D.S.; Set 1/2 mile post; Beech 6" S18W 71ks., Beech 6" N7W 381ks. * 1985 Gravlin, P.S.#23510; Survey L.006, Pg.945 - Fnd. 1/2" iron 1988 Gravlin, P.S.#23510; Survey L.008, Pg.71-72 - Fnd. 1/2" iron; same 3 wits as 1985 survey 1989 Gravlin, P.S.#23510; LCRC L.004, Pg.236 - Fnd. 1/2" iron; same 3 wits as 1985 survey


- * 1906 Sickledsted, C.S.; Stake, Pine 34" N77 1/2 W 781ks., Pine 44" S83E 891ks.

- B. Description of corner evidence found and/or method applied in restoring or reestablishing corner: 1993 Rowe Eng. - Field, P.S.#37276; Fnd. 1/2"x12" rod on centerline of gravel road N-S (top 1/2 of rod bent and twisted - removed and replaced with new 1/2" rod) Fnd. 2 previous witnesses which verify that rod is in same position as 1985 Gravlin survey.

Accepted fnd. 1/2" rod as best evidence of original corner position

- C. Description of monument for corner and accessories established to perpetuate locating the position of the corner:

M-10 1/2" rod w/ standard brass cap S30°E, 89.10' Set nail w/remon tag above fnd. 40d nail in NE face P.pole S70°W, 106.22' NE Cor. of conc. foundation of house #4739 N60°E, 39.89' Fnd. 1/2" rod w/broken cap West, 32.95' Fnd. rod w/cap #23510 N85°W, 17.68' Set punch hole in top center S. end 12" CSP N40°W, 30.86' Set punch hole in top center N. end 12" CSP

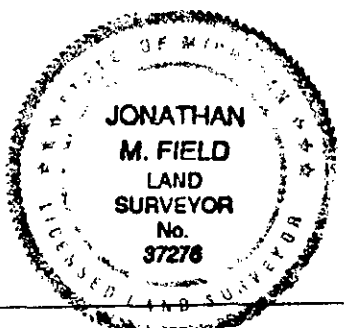

Signed by Jonathan M. Field Date 11-24-93 Surveyor's Michigan License No. 37276