SURVEY &
REMONUMENTATION

1993

COMMISSION

REMONUMENTATION
LAND CORNER RECORDATION CERTIFICATE
Filing Requirement of Act 74, Mich. P.A. 1970

RECEIVED FOR RECORD
94 JAN -4 PM 12: 53
LIBER 005 PAGE 60
Melissa Miles
REGISTER OF DEEDS
LAPEER COUNTY, MICHIGAN

Register of Deeds Stamp & File Number

For corners in
LAPEER
(County)

	Located In:	Corner Code #
1. Public Land Survey	T 9 N R 9 E	M-13
	T ____ R ____	
	T ____ R ____	
	T ____ R ____	Reg #1
2. Property Controlling	S ____ T ____ R ____	
in Section	S ____ T ____ R ____	
3. Miscellaneous	S ____ T ____ R ____	
Property in Sec.	S ____ T ____ R ____	

4. Lot No. _____ , Recorded Plat _____
5. Private Claims _____

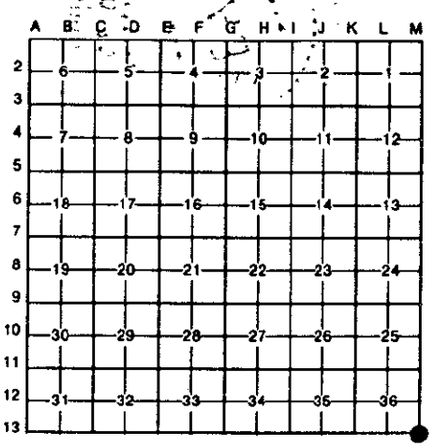

I, Jonathan M. Field, in a field survey on October, 1993, do hereby certify that under requirements of P.A. 74, Michigan P.A. of 1970, the corner points mentioned in lines 1 and 2 above were in conformance with regulations and rules therefore as required in the current manual of survey instructions of the United States Department of the Interior, Bureau of Land Management or by a decree of a Court of Law and/or that the corner points mentioned in lines 3, 4 and 5 above were in conformance with the rules of the Michigan Board of Land Surveyors or by a Decree of a Court of Law; established, re-established, monumented, re-monumented, recovered, found as expressed below:

NOTE: Not more than 4 corners, all in the same town and range, may be recorded on this certificate.

A. Description of original monument and accessories and/or subsequent restoration:
1822 GLO- Wampler, D.S.; Set post; Elm 7" S13W 80lks., Linden 13" N35E 93lks.
1977 Bates, P.S.#16699; Survey L.084, Pg.408-409 - Set iron
1978 Bates, P.S.#16699; Survey L.004, Pg.474-476 - Fnd. 1/2" rod; same wits as 1977 survey
1978 Bates, P.S.#16699; LCRC L.003, Pg.380 - Fnd. 1/2" rod; same wits as 1977 survey

B. Description of corner evidence found and/or method applied in restoring or reestablishing corner:
1993 Rowe Eng. - Field, P.S.#37276; Fnd. 1/2"x18" rod bent and leaning NNE'ly - removed
Set new 1/2" rod using 3 fnd. wits. of 1977 rod is 2' N of centerline of gravel road E-W and on fenceline running North (fence all down)

Accepted location indicated by 3 remaining witnesses as best evidence of original corner position.

C. Description of monument for corner and accessories established to perpetuate locating the position of the corner:
M-13 1/2" rod w/ standard brass cap
N13°E, 21.12' Set nail w/remon tag above fnd. P-K nail w/disc in NW face 10" Ash in clump
S42°E, 47.16' Set nail w/remon tag above fnd. P-K nail w/disc in NE face 8" Ash
S70°W, 70.18' Set nail w/remon tag above fnd. P-K nail w/disc in N. face 16" Oak
N64°E, 33.53' Set nail w/remon tag in NW face 16" Willow
N60°W, 36.60' Set nail w/remon tag in SW face 8" Ash

JONATHAN M. FIELD LAND SURVEYOR No. 37276

Signed by Jonathan M Field Date 11-24-93
Surveyor's Michigan License No. 37276

FORM APPROVED BY MICHIGAN STATE BOARD OF LAND SURVEYORS, JAN. 28, 1971
REVISED MAY 14, 1975
REVISED JAN., 1983

LIBER 005 PAGE 60