

SURVEY & REMONUMENTATION

MAR 13 1998


SECTION

**1997 REMONUMENTATION PROGRAM
LAND CORNER RECORDATION CERTIFICATE**
Filing Requirement of Act 74, Mich. P.A. 1970

RECEIVED FOR RECORD
97 NOV 12 PM 2: 51

For corners in: **MARATHON TWP.**

<u>LAPEER</u> (County)	Located In:	Corner Code #
1. Public Land Survey	T <u>09N</u> R <u>09E</u>	<u>M-13</u>
	T _____ R _____	_____
	T _____ R _____	_____
	T _____ R _____	_____
2. Property Controlling in Section	S _____ T _____ R _____	<u>log #2</u>
	S _____ T _____ R _____	_____
3. Miscellaneous Property in Sec.	S _____ T _____ R _____	_____
	S _____ T _____ R _____	_____
4. Lot No. _____, Recorded Plat _____		
5. Private Claims _____		

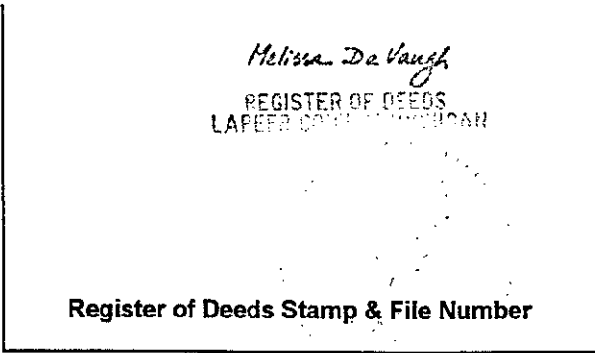

	A	B	C	D	E	F	G	H	I	J	K	L	M
1													
2	6	5	4	3	2	1							
3													
4	7	8	9	10	11	12							
5													
6	18	17	16	15	14	13							
7													
8	19	20	21	22	23	24							
9													
10	30	29	28	27	26	25							
11													
12	31	32	33	34	35	36							
13													

I, JONATHAN M. FIELD, in a field survey on JUNE 19 97, do hereby certify that under requirements of P.A. 74, Michigan P.A. of 1970, the corner points mentioned in lines 1 and 2 above were in conformance with regulations and rules therefore as required in the current manual of survey instructions of the United States Department of the Interior, Bureau of Land Management or by a decree of a Court of Law and/or that the corner points mentioned in lines 3, 4 and 5 above were in conformance with the rules of the Michigan Board of Land Surveyors or by a Decree of a Court of Law; established, re-established, monumented, re-monumented, recovered, found as expressed below:

NOTE: Not more than 4 corners, all in the same town and range, may be recorded on this certificate.

A. Description of original monument and accessories and/or subsequent restoration:
 1834 GLO; WAMPLER, D.S.; SET POST; ELM 7" S13W 80LKS., LINDEN 13" N35E 93LKS.
 1977 HENDERSON-BATES; BATES, P.S.#16699; SURVEY; L.084,PG.408; SET IRON N10E 21.12' 10" BUTTERNUT, S50W 70.18' 12" OAK, S45E 47.16' 10" ASH
 1978 HENDERSON-BATES; BATES, P.S.#16699; SURVEY; L.004,PG.474; FND. 1/2" ROD; SAME WITS AS 1977 SURVEY
 1978 BATES, P.S.#16699; LCRC; L.003,PG.380; FND. 1/2" ROD; SAME WITS AS 1977 SURVEY ABOVE
 1993 FIELD, P.S.#37276; 1993 REMON LCRC; FND. 1/2" ROD

A-13 TO A-12 2633.99' HENDERSON-BATES '77
 A-13 TO M-12 2615.75' HENDERSON-BATES '77
 A-13 TO L-13 2640.28' HENDERSON-BATES '77

B. Description of corner evidence found and/or method applied in restoring or reestablishing corner:
 1997 ROWE; FIELD, PS#37276; FND. 1/2" W/ STANDARD REMON CAP

NOTE: THIS CORNER IS COMMON WITH A-1 T8N-R10E, M-1 T8N-R9E, AND A-13 T9N-R10E

C. Description of monument for corner and accessories established to perpetuate locating the position of the corner:
 M-13 1/2" ROD W/ STANDARD REMON CAP
 N13°E, 21.12' NAIL W/ REMON TAG IN NW FACE 10" ASH
 S42°E, 47.16' NAIL W/ REMON TAG IN NE FACE 8" ASH
 S70°W, 70.18' NAIL W/ REMON TAG IN N. FACE 16" OAK
 N64°E, 33.53' NAIL W/ REMON TAG IN NW FACE 16" WILLOW
 N60°W, 36.60' NAIL W/ REMON TAG IN SW FACE 8" ASH



Signed by Jonathan M. Field Date 11-11-97
 Surveyor's Michigan License No. 37276

APPROVED LAND CORNER
 PA 345 OF 1990
 LAPEER COUNTY
FORM APPROVED BY MICHIGAN BOARD OF LAND SURVEYORS, JAN. 28, 1971
 REVISED MAY 14, 1975
 REVISED JAN. 1983
 ADAPTED FOR WORD PROCESSING MARCH, 1993

LIBER0005 PAGE0449

RAY DAVIS P.S. CO. SURVEYOR
 DATE 9-29-97

9