

LAND CORNER RECORDATION CERTIFICATE
Filing Requirement of Act 74, Mich. P.A. 1970

For corners in
Lapeer
(County)

Located In:

Corner Code ##

1. Public Land Survey	T <u>9N</u> R <u>10E</u>	C12
	T <u>9N</u> R <u>10E</u>	C13
	T _____ R _____	_____
	T _____ R _____	_____
2. Property Controlling in Section	S _____ T _____ R _____	_____
	S _____ T _____ R _____	_____
3. Miscellaneous Property in Sec.	S _____ T _____ R _____	_____
	S _____ T _____ R _____	_____

Register of Deeds Stamp & File Number

4. Lot No. _____, Recorded Plat _____
 5. Private Claims _____

I, Gary C. Bilow, in a field survey on March 14, 1991, 19_____, do hereby certify that under requirements of P.A. 74, Michigan P.A. of 1970, the corner points mentioned in lines 1 and 2 above were in conformance with regulations and rules therefore as required in the current manual of survey instructions of the United States Department of the Interior, Bureau of Land Management or by a decree of a Court of Law and/or that the corner points mentioned in lines 3, 4 and 5 above were in conformance with the rules of the Michigan Board of Land Surveyors or by a Decree of a Court of Law; established, re-established, monumented, re-monumented, recovered, found as expressed below:

NOTE: Not more than 4 corners, all in the same town and range, may be recorded on this certificate.

	A	B	C	D	E	F	G	H	I	J	K	L	M
2	6	5	4	3	2								
3													
4	7	8	9	10	11	12							
5													
6	18	17	16	15	14	13							
7													
8	19	20	21	22	23	24							
9													
10	30	29	28	27	26	25							
11													
12	31	32	33	34	35	36							
13													

A. Description of original monument and accessories and/or subsequent restoration:


C12: Post established by U.S. Deputy Surveyor H. Burnham in 1835 - accessories: Maple 10, S72E 23; Beech 6, N31W 10. County Surveyor F.A. Sicksteel records in County Surveyor Records on pages 42 and 43 in 1906 "Stake - White Oak 30, S25W 19 and White Oak 26, S4W 84" as stated in the field notes of Gilbert Bates dated 1874." Corner recorded under Act 74, PA 1970 by B. Henderson (LLS #16043) in 1974 in Liber 2, Page 669 as "Found 1/2" rod - accessories: N50E 29.95', 6" Birch; S85E 16.58', 6" Oak; S15W 17.08', 6" Poplar."
 C13: Post established by U.S. Deputy Surveyor J. Waapler in 1822 - accessories: Pine 32, N85W 42 and White Oak 22, N76E 59. Corner recorded under Act 74, PA 1970 by Dwayne Scott (LLS #12029) in 1971 in Liber 1, Page 51 as "Found 1/2" iron rod 2" below gravel surface with information furnished by Henderson & Bates Surveyors in Lapeer - accessories: S62E 70.65', 8" Willow; N68W 93.86', Telephone pole; N4E 33.0', 3/8" iron rod; N2W 42.06', 8" Oak; N40E 30.50', 8" Sassafras."

B. Description of corner evidence found and/or method applied in restoring or reestablishing corner:

C12: Found 1/2" rod flush to west side of 8" diameter fence post and two (2) of Henderson's witnesses. Accepted corner as the best evidence of the original GLO post.
 C13: Found 1/2" iron rod 3" below road surface and one (1) of Scott's witnesses. Accepted this corner as the best evidence of the original GLO post.

C. Description of monument for corner and accessories established to perpetuate locating the position of the corner:

C12: Found 1/2" rod	C13: Found 1/2" iron rod
N50E 29.93', N&T in NW face 7'	N68W 94.30', PK in Telephone pole
Birch	N4E 33.0', 3/8" iron rod
S84E 16.58', N&T in South face 9"	North 41.95', N&T in West face 20"
Oak	Oak
S30W 17.30', N&T in SE face 9"	N45E 32.35', N&T in NW face 6"
Poplar	Sassafras
S33E 4.85', N&T in SW face 8" Oak	

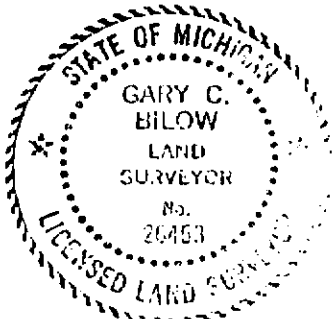

Signed by Gary C. Bilow Date 5/11/92