

LAND CORNER RECORDATION CERTIFICATE
Filing Requirement of Act 74, Mich. P.A. 1970

For corners in
Lapeer
(County)

Located In: _____ Corner Code 11

1. Public Land Survey	T <u>9N</u> R <u>10E</u>	<u>A12</u>
	T <u>9N</u> R <u>10E</u>	<u>B12</u>
	T _____ R _____	_____
	T _____ R _____	_____
2. Property Controlling in Section	S _____ T _____ R _____	_____
	S _____ T _____ R _____	_____
3. Miscellaneous Property in Sec.	S _____ T _____ R _____	_____
	S _____ T _____ R _____	_____

Register of Deeds Stamp & File Number

4. Lot No. _____, Recorded Plat _____
 5. Private Claims _____

I, Gary C. Bilow, in a field survey on March 09, 1992, 19_____, do hereby certify that under requirements of P.A. 74, Michigan P.A. of 1970, the corner points mentioned in lines 1 and 2 above were in conformance with regulations and rules therof as required in the current manual of survey instructions of the United States Department of the Interior, Bureau of Land Management or by a decree of a Court of Law and/or that the corner points mentioned in lines 3, 4 and 5 above were in conformance with the rules of the Michigan Board of Land Surveyors or by a Decree of a Court of Law; established, re-established, monumented, re-monumented, recovered, found as expressed below:

NOTE: Not more than 4 corners, all in the same town and range, may be recorded on this certificate.

	A	B	C	D	E	F	G	H	I	J	K	L	M
2	6	5	4	3	2	1							
3													
4	7	8	9	10	11	12							
5													
6	18	17	16	15	14	13							
7													
8	19	20	21	22	23	24							
9													
10	30	29	28	27	26	25							
11													
12	●	●	32	33	34	35	36						
13													

A. Description of original monument and accessories and/or subsequent restoration:


A12: Post not established by U.S. General Land Office Survey. Corner shown on survey recorded under Act 132, PA 1970 by L. Bates (LLS #16699) in January 1978 in Liber 4, Pages 474 to 476 - accessory: N 01° 28' 19" W 18.24' north of corner M-12 at fence intersection.
 B12: Post not established in U.S. General Land Office Survey. Corner shown on survey recorded under Act 132, PA 1970 by Bernard Henderson (LLS #16043) in February 1974 in Liber 3, Pages 7 to 9 as a 42" dead Elm with a Reference Iron set 3' East. Gives no accessories.

B. Description of corner evidence found and/or method applied in restoring or reestablishing corner:

A12: Found L. Bates's corner as recorded to be 10.07' north of midpoint in old fence line. Did not accept this iron as the corner. Established corner equidistant between corners A13 (M13) and A11 in old fence line.
 B12: Found B. Henderson's corner as recorded to be 11.2' South of the intersection of the N-S and E-W 1/4 lines. Established corner at the intersection of the N-S and E-W 1/4 lines.

C. Description of monument for corner and accessories established to perpetuate locating the position of the corner:

A12: Set 1/2" x 3/8" rebar encased in 4" diameter concrete cylinder and capped with a cast aluminum Department of Natural Resources Tablet	B12: Set 1/2" x 3/8" rebar encased in 4" diameter concrete cylinder & capped with a cast aluminum Michigan Department of Natural Resources Tablet
S5E 6.12', N&T in West face 6" Poplar	N44W 6.32', N&T in East face 5" Poplar
S25W 41.19', N&T in SE face 20" Oak	S38W 24.09', N&T in South face 12" Poplar
N80E 11.61', N&T in North face 7" Poplar	S32E 10.56', N&T in SW face 8" Poplar
N50W 21.62', N&T in South face twin 5"-12" Oak	S41W 20.46', N&T in SE face 6" Cherry
N2W 10.07', 1/2" iron bar	

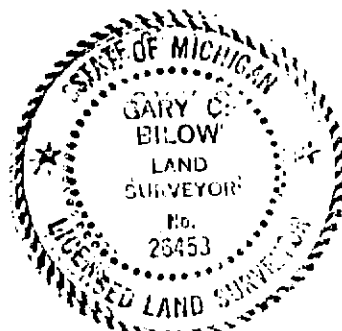

Signed by Gary C. Bilow Date 3/10/92