

**SURVEY & REMONUMENTATION**

**MAR 13 1998**


**SECTION**

**1997 REMONUMENTATION PROGRAM  
LAND CORNER RECORDATION CERTIFICATE**  
Filing Requirement of Act 74, Mich. P.A. 1970

**RECEIVED FOR RECORD  
97 NOV 12 PM 2:42**

For corners in: **DEERFIELD TWP.**

<u>LAPEER</u> (County)	Located In:	Corner Code #
1. Public Land Survey	T <u>09N</u> R <u>10E</u>	<u>A-7</u>
	T _____ R _____	_____
	T _____ R _____	_____
	T _____ R _____	_____
2. Property Controlling in Section	S _____ T _____ R _____	_____
	S _____ T _____ R _____	_____
3. Miscellaneous Property in Sec.	S _____ T _____ R _____	_____
	S _____ T _____ R _____	_____
4. Lot No. _____, Recorded Plat _____		
5. Private Claims _____		

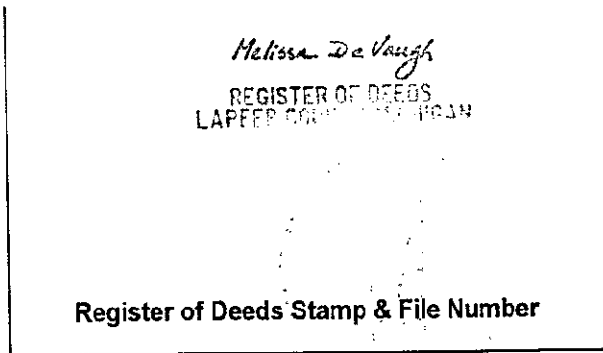

	A	B	C	D	E	F	G	H	I	J	K	L	M
1													
2	6	5	4	3	2	1							
3													
4	7	8	9	10	11	12							
5													
6	18	17	16	15	14	13							
7													
8	19	20	21	22	23	24							
9													
10	30	29	28	27	26	25							
11													
12	31	32	33	34	35	36							
13													

I, JONATHAN M. FIELD, in a field survey on JUNE 19 97, do hereby certify that under requirements of P.A. 74, Michigan P.A. of 1970, the corner points mentioned in lines 1 and 2 above were in conformance with regulations and rules therefore as required in the current manual of survey instructions of the United States Department of the Interior, Bureau of Land Management or by a decree of a Court of Law and/or that the corner points mentioned in lines 3, 4 and 5 above were in conformance with the rules of the Michigan Board of Land Surveyors or by a Decree of a Court of Law; established, re-established, monumented, re-monumented, recovered, found as expressed below.

**NOTE: Not more than 4 corners, all in the same town and range, may be recorded on this certificate.**

A. Description of original monument and accessories and/or subsequent restoration:  
 1834 GLO; BURNHAM, D.S.; SET POST; BEECH 7 N58E 29LKS., BEECH 7 S53E 25LKS.  
 1973 HENDERSON-BATES; ELRICH, P.S.#18986; SURVEY; L.002,PG.383; NO OBJECT STATED; NORTH 23.83' NAIL W/TAG IN COR. POST, N45E 51.42' NAIL W/TAG IN 36" OAK, S40W 72.25' NAIL W/TAG IN P.POLE  
 1974 KAY ENG.; KAY, P.S.#14096; SURVEY; L.002,PG.687-688; NO OBJECT STATED; SAME WITS AS 1973 SURVEY ABOVE  
 1987 HENDERSON-BATES; ELRICH, P.S.#18986; SURVEY; L.008, PG.64; FND. 1/2" IRON; SAME WITS AS 1973 SURVEY ABOVE (NOTE: CORNER IS INCORRECTLY LABELED W1/4 COR.)  
 1988 HENDERSON-BATES; ELRICH, P.S.#18986; SURVEY; L.008,PG.61; FND. 1/2" IRON; SAME WITS AS 1973 SURVEY  
 1992 HENDERSON-BATES; ELRICH, P.S.#18986; SURVEY; L.009,PG.848; FND. 1/2" IRON #16043; S40W 75.22' P.POLE, NORTH 23.94' COR. POST, N45E 51.42' 42" OAK

A-7 TO A-6 2661.92' HENDERSON-BATES '88  
 A-7 TO A-8 2669.16' HENDERSON-BATES '92 2669.38' REI '97


A-7 TO M-7 146.52' G.L.O.  
 130.47' REI '94

A-7 TO B-7 2083.84' HENDERSON-BATES '73-'92 & KAY ENG. '74

B. Description of corner evidence found and/or method applied in restoring or reestablishing corner:  
 1997 ROWE; FIELD, PS#37276; FND. 1/2" ROD W/ BROKEN CAP IN N-S FENCE LINE & 2' N. OF C/L GRAVEL ROAD TO E.

C. Description of monument for corner and accessories established to perpetuate locating the position of the corner:  
 A-7 1/2" ROD W/ STANDARD REMON CAP

SOUTH, 10.15' NAIL W/ REMON TAG IN W. FACE 10" OAK  
 S40°W, 75.29' NAIL W/ DISK IN NE FACE P.POLE  
 N20°W, 44.85' NAIL W/ REMON TAG IN W. FACE 30" WHITE PINE  
 N60°E, 50.54' NAIL W/ REMON TAG IN NW FACE 42" OAK  
 SOUTH, 130.47' 1/2" ROD W/ REMON CAP AT M-7 T9N-R9E

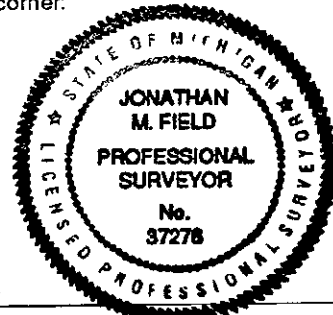

Signed by Jonathan M. Field Date 11-11-97  
 Surveyor's Michigan License No. 37276

DEER GROUP  
 APPROVED LAND CORNER  
 PA 345 OF 1090  
 LAPEER COUNTY

FORM APPROVED BY MICHIGAN STATE BOARD OF LAND SURVEYORS, JAN 28, 1971

REVISED MAY 14, 1975  
 REVISED JAN. 1983  
 ADAPTED FOR WORD PROCESSING MARCH, 1993

LIDER0005 PAGE0441

Ray Davis  
 RAY DAVIS P.S. CO SURVEYOR  
 DATE 9-29-97