

**SURVEY & REMONUMENTATION**

MAR 13 1998

SECTION

**1997 REMONUMENTATION PROGRAM  
LAND CORNER RECORDATION CERTIFICATE**  
Filing Requirement of Act 74, Mich. P.A. 1970

RECEIVED FOR RECORD  
97 NOV 12 PM 2:43

For corners in: DEERFIELD TWP.

<u>LAPEER</u> (County)	Located In:	Corner Code #
1. Public Land Survey	T <u>09N</u> R <u>10E</u>	<u>A-8</u>
	T _____ R _____	_____
	T _____ R _____	_____
	T _____ R _____	_____
2. Property Controlling in Section	S _____ T _____ R _____	_____
	S _____ T _____ R _____	_____
3. Miscellaneous Property in Sec.	S _____ T _____ R _____	_____
	S _____ T _____ R _____	_____
4. Lot No. _____ Recorded Plat _____		
5. Private Claims _____		

*Melissa DeVaugh*  
REGISTER OF DEEDS  
LAPEER COUNTY, MICHIGAN

Register of Deeds Stamp & File Number

I, JONATHAN M. FIELD, in a field survey on JUNE 19 97, do hereby certify that under requirements of P.A. 74, Michigan P.A. of 1970, the corner points mentioned in lines 1 and 2 above were in conformance with regulations and rules therefore as required in the current manual of survey instructions of the United States Department of the Interior, Bureau of Land Management or by a decree of a Court of Law and/or that the corner points mentioned in lines 3, 4 and 5 above were in conformance with the rules of the Michigan Board of Land Surveyors or by a Decree of a Court of Law; established, re-established, monumented, re-monumented, recovered, found as expressed below:

**NOTE: Not more than 4 corners, all in the same town and range, may be recorded on this certificate.**

	A	B	C	D	E	F	G	H	I	J	K	L	M
1													
2	6	5	4	3	2	1							
3													
4	7	8	9	10	11	12							
5													
6	18	17	16	15	14	13							
7													
8	19	20	21	22	23	24							
9													
10	30	29	28	27	26	25							
11													
12	31	32	33	34	35	36							
13													

A. Description of original monument and accessories and/or subsequent restoration:  
 1834 GLO; BURNHAM, D.S.; NOT SET DURING ORIGINAL GOVERNMENT SURVEY  
 1972 HENDERSON-BATES; HENDERSON, P.S.#16043; SURVEY; L.001, PG.838-841; FND. 1/2" ROD; N30E 84.47' TRIPLE 12" TREE, S88E 29.50' P.POLE, S25E 71.70' TREE  
 1992 HENDERSON-BATES; ELRICH, P.S.#18986; SURVEY; L.009, PG.848; FND. 1/2" IRON; S88E 29.51' PHONE RISER, N20E 84.47' 12" TRI OAK, S20E 71.70' 14" CHESNUT  
 1994 FIELD, P.S.#37276; 1994 REMON LCRC FOR M-8 T9N-R9E; TIE OF NORTH 120.26' TO FND. 1/2" ROD (A-8)

A-8 TO A-7 2669.16' HENDERSON-BATES '92 2669.38' REI '97  
 A-8 TO A-9 2671.55' HENDERSON-BATES '92 2671.56' REI '97


A-8 TO M-8 112.53' AVG. G.L.O.  
 120.26' REI '94

A-8 TO B-8 2063.58' HENDERSON-BATES '72

B. Description of corner evidence found and/or method applied in restoring or reestablishing corner:  
 1997 ROWE; FIELD, PS#37276; FND. 1/2" ROD 7' W. OF C/L GRAVEL ROAD N-S & ON OCC. TREE LINE TO E.

C. Description of monument for corner and accessories established to perpetuate locating the position of the corner:

A-8 1/2" ROD W/ STANDARD REMON CAP  
 EAST, 29.47' P-K NAIL W/ REMON TAG IN N. FACE CUT-OFF T.POLE  
 N30°E, 84.53' NAIL W/ REMON TAG IN NW FACE TRIPLE 14" ASH  
 N10°W, 93.02' NAIL W/ REMON TAG IN E. FACE 12" ASH  
 S35°E, 48.18' NAIL W/ REMON TAG IN SW FACE 10" SCOTCH PINE  
 S20°W, 46.97' TOP CENTER OF PHONE RISER  
 S20°E, 72.29' NAIL W/ REMON TAG IN SW FACE 16" CHESTNUT

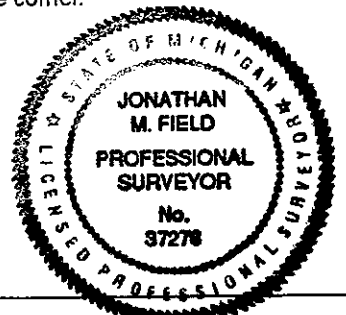

Signed by Jonathan M. Field Date 11-11-97

Surveyor's Michigan License No. 37276

PEER GROUP  
 APPROVED LAND CORNER  
 PA 345 OF 1090  
 LAPEER COUNTY

RAY DAVIS P.S. CO. SURVEYOR  
 DATE 9-29-97

LIBER0005 PAGE0442

FORM APPROVED BY MICHIGAN STATE BOARD OF LAND SURVEYORS, JAN. 28, 1971  
 REVISED MAY 14, 1975  
 REVISED JAN., 1983  
 ADAPTED FOR WORD PROCESSING MARCH, 1993

9