

SURVEY & REMONUMENTATION

MAR 13 1998

**1997 REMONUMENTATION PROGRAM
LAND CORNER RECORDATION CERTIFICATE**
Filing Requirement of Act 74, Mich. P.A. 1970

RECEIVED FOR RECORD

97 NOV 12 PM 2:44

SECTION

For corners in: **DEERFIELD TWP.**

LAPEER

(County)

Located In:

Corner Code #

- | | | |
|------------------------------------|---------------------------|------------|
| 1. Public Land Survey | T <u>09N</u> R <u>10E</u> | <u>A-9</u> |
| | T _____ R _____ | _____ |
| | T _____ R _____ | _____ |
| | T _____ R _____ | _____ |
| 2. Property Controlling in Section | S _____ T _____ R _____ | _____ |
| | S _____ T _____ R _____ | _____ |
| 3. Miscellaneous Property in Sec. | S _____ T _____ R _____ | _____ |
| | S _____ T _____ R _____ | _____ |
| 4. Lot No. _____ | Recorded Plat _____ | |
| 5. Private Claims _____ | | |

Melina DeVaugh
REGISTER OF DEEDS
LAPEER COUNTY, MICHIGAN

Register of Deeds Stamp & File Number

	A	B	C	D	E	F	G	H	I	J	K	L	M
1													
2	6	5	4	3	2	1							
3													
4	7	8	9	10	11	12							
5													
6	18	17	16	15	14	13							
7													
8	19	20	21	22	23	24							
9													
10	30	29	28	27	26	25							
11													
12	31	32	33	34	35	36							
13													

I, **JONATHAN M. FIELD**, in a field survey on JUNE 19 97, do hereby certify that under requirements of P.A. 74, Michigan P.A. of 1970, the corner points mentioned in lines 1 and 2 above were in conformance with regulations and rules therefore as required in the current manual of survey instructions of the United States Department of the Interior, Bureau of Land Management or by a decree of a Court of Law and/or that the corner points mentioned in lines 3, 4 and 5 above were in conformance with the rules of the Michigan Board of Land Surveyors or by a Decree of a Court of Law; established, re-established, monumented, re-monumented, recovered, found as expressed below:

NOTE: Not more than 4 corners, all in the same town and range, may be recorded on this certificate.

- A. Description of original monument and accessories and/or subsequent restoration:
 1834 GLO; BURNHAM, D.S.; SET POST; MAPLE 18 N59E 9LKS., BEECH 12 S31E 9LKS.
 1972 FLINT SURVEYING; CARLSON, P.S.#9189; SURVEY; L.001,PG.582; NO OBJECT STATED; EAST 21.38' COR. POST, S30W 76.96' 12" ASH, S85W 110.82' SE COR. HOUSE #5007
 1972 HENDERSON-BATES; HENDERSON, P.S.#16043; SURVEY; L.001,PG.838-841; FND. IRON; SAME WITS AS 1972 SURVEY ABOVE
 1974 GIFFELS-WEBSTER; PAWLACZYK, P.S.#17632; SURVEY; L.002,PG.559-563; FND. 1/2" ROD; SAME WITS AS 1972 SURVEY ABOVE
 1974 GIFFELS-WEBSTER; PAWLACZYK, P.S.#17632; SURVEY; L.002,PG.615-617; 1/2" ROD; SAME WITS AS 1972 SURVEY ABOVE
 1994 FIELD, P.S.#37276; 1994 REMON LCRC FOR M-9 T9N-R9E; TIE OF NORTH 77.22' TO FND. T-IRON (A-9)

A-9 TO A-8 2671.55' HENDERSON-BATES '72 2671.56' REI '97
 A-9 TO A-10 2697.94' G.W.E. '74 2698.02' REI '97

A-9 TO M-9 78.54' G.L.O.
 77.22' REI '94


A-9 TO B-9 2041.96' HENDERSON-BATES '72; 2041.11 G.W.E. '74

- B. Description of corner evidence found and/or method applied in restoring or reestablishing corner:
 1997 ROWE; FIELD, PS#37276; FND. T-IRON AT C/L GRAVEL ROAD N-S & ON OCCUPIED TREE/FENCE LINE TO E.

- C. Description of monument for corner and accessories established to perpetuate locating the position of the corner:
 A-9 REPLACED FND. T-IRON W/ 1/2" ROD W/ STANDARD REMON CAP

- S85°E, 25.56' P-K NAIL W/ REMON TAG IN S. FACE P.POLE
- N30°W, 66.94' P-K NAIL W/ REMON TAG IN SW FACE P.POLE
- S80°W, 27.90' NAIL W/ REMON TAG IN SE FACE TWIN 6" ELM
- S40°E, 36.36' P-K NAIL W/ REMON TAG IN SW FACE 8" OAK
- S30°W, 79.96' NAIL W/ REMON TAG IN NW FACE 20" ASH
- S85°W, 110.8' SE COR. HOUSE #5007

Signed by Jonathan M. Field Date 11-11-97
 Surveyor's Michigan License No. 37276

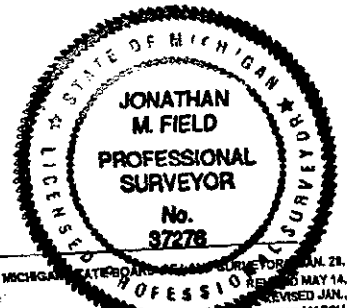

FORM APPROVED BY MICHIGAN BOARD OF LAND SURVEYORS JAN. 28, 1971
 PROFESSIONAL SURVEYOR
 REVISED MAY 14, 1975
 ADAPTED FOR PROCESSING MARCH, 1993

PEER GROUP
 APPROVED LAND CORNER
 PA 345 OF 1990
 LAPEER COUNTY

RAY DAWS P.S. CO. SURVEYOR
 DATE 9-29-97

LIBER 0005 PAGE 0443