

SURVEY & REMONUMENTATION

MAR 13 1998

SECTION

**1997 REMONUMENTATION PROGRAM
LAND CORNER RECORDATION CERTIFICATE**
Filing Requirement of Act 74, Mich. P.A. 1970

RECEIVED FOR RECORD

97 NOV 12 PM 2:47

For corners in: **DEERFIELD TWP.**

| | | |
|---------------------------------------|---------------------------|---------------|
| <u>LAPEER</u> (County) | Located In: | Corner Code # |
| 1. Public Land Survey | T <u>09N</u> R <u>10E</u> | <u>A-11</u> |
| | T _____ R _____ | _____ |
| | T _____ R _____ | _____ |
| | T _____ R _____ | _____ |
| 2. Property Controlling in Section | S _____ T _____ R _____ | _____ |
| | S _____ T _____ R _____ | _____ |
| 3. Miscellaneous Property in Sec. | S _____ T _____ R _____ | _____ |
| | S _____ T _____ R _____ | _____ |
| 4. Lot No. _____, Recorded Plat _____ | | |
| 5. Private Claims _____ | | |

Melissa De Vaughn
REGISTER OF DEEDS
LAPEER COUNTY, MICHIGAN

Register of Deeds Stamp & File Number

| | A | B | C | D | E | F | G | H | I | J | K | L | M |
|----|----|----|----|----|----|----|---|---|---|---|---|---|---|
| 1 | | | | | | | | | | | | | |
| 2 | 6 | 5 | 4 | 3 | 2 | 1 | | | | | | | |
| 3 | | | | | | | | | | | | | |
| 4 | 7 | 8 | 9 | 10 | 11 | 12 | | | | | | | |
| 5 | | | | | | | | | | | | | |
| 6 | 18 | 17 | 16 | 15 | 14 | 13 | | | | | | | |
| 7 | | | | | | | | | | | | | |
| 8 | 19 | 20 | 21 | 22 | 23 | 24 | | | | | | | |
| 9 | | | | | | | | | | | | | |
| 10 | 30 | 29 | 28 | 27 | 26 | 25 | | | | | | | |
| 11 | | | | | | | | | | | | | |
| 12 | 31 | 32 | 33 | 34 | 35 | 36 | | | | | | | |
| 13 | | | | | | | | | | | | | |

I, JONATHAN M. FIELD, in a field survey on JUNE 19 97, do hereby certify that under requirements of P.A. 74, Michigan P.A. of 1970, the corner points mentioned in lines 1 and 2 above were in conformance with regulations and rules therefore as required in the current manual of survey instructions of the United States Department of the Interior, Bureau of Land Management or by a decree of a Court of Law and/or that the corner points mentioned in lines 3, 4 and 5 above were in conformance with the rules of the Michigan Board of Land Surveyors or by a Decree of a Court of Law; established, re-established, monumented, re-monumented, recovered, found as expressed below:

NOTE: Not more than 4 corners, all in the same town and range, may be recorded on this certificate.

- A. Description of original monument and accessories and/or subsequent restoration:
- 1834 GLO; BURNHAM, D.S.; SET POST; MAPLE 12 N28E 36LKS., BECH 12 S45E 34LKS.
 - 1972 HENDERSON-BATES; ELRICH, P.S.#18986; SURVEY; L.001,PG.886; SET P-K NAIL; NORTH, 37.0' 6" CHERRY, N60E 92.56' 30" MAPLE, SOUTH 51.37' 20" MAPLE
 - 1973 HENDERSON-BATES; HENDERSON, P.S.#16043; SURVEY; L.002,PG.005; FND. R.R. SPIKE; N30E 44.93' P.POLE, N40E 41.90' ROAD SIGN, S10E 72.26' P.POLE
 - 1978 HENDERSON-BATES; ELRICH, P.S.#18986; SURVEY; L.005,PG.038-039; NO OBJECT STATED; SAME WITS AS 1973 SURVEY ABOVE
 - 1985 GRAVLIN, P.S.#23510; SURVEY L.007,PG.085; FND. 1/2" IRON; SAME WITS AS 1973 SURVEY ABOVE
 - 1992 DAVIS, P.S.#22430; LCRC; L.004,PG.405; TIE OF NORTH 47.70' TO "SEC. CORNER DEERFIELD"
 - 1993 DAVIS, P.S.#22430; LCRC; L.004,PG.415; SAME REFERENCE TIE AS 1992 LCRC ABOVE
 - 1993 FIELD, P.S.#37276; 1993 REMON LCRC FOR M-11 T9N-R9E; TIE OF NORTH 47.70' TO FND. 1/2" ROD IN MON BOX


A-11 TO A-10 2611.47' HENDERSON-BATES '73 2611.64' REI '97 A-11 TO M-11 38.94' G.L.O.
 A-11 TO A-12 2597.52' HENDERSON-BATES '78 47.65' H-B '78
 A-11 TO B-11 2045.68' HENDERSON-BATES '78 47.70' REI '93

B. Description of corner evidence found and/or method applied in restoring or reestablishing corner:
 1997 ROWE; FIELD, PS#37276; FND. 1/2" ROD IN MON BOX AT C/L GRAVEL ROAD TO N. & C/L EXTENDED OF ASPH. ROAD TO E.

C. Description of monument for corner and accessories established to perpetuate locating the position of the corner:
 A-11 1/2" ROD W/ STANDARD REMON CAP IN MON BOX
 S60°W, 28.09' S. CORNER OF SQUARE CATCH BASIN RIM
 S60°E, 31.33' S. CORNER OF SQUARE CATCH BASIN RIM
 N40°E, 44.95' FND. NAIL W/ REMON. TAG IN SE FACE CUT-OFF T.POLE
 N25°W, 111.87' P-K NAIL W/TAG #37276 IN SW FACE P.POLE

Signed by Jonathan M. Field
 Surveyor's Michigan License No. 37276

Date 11-11-97

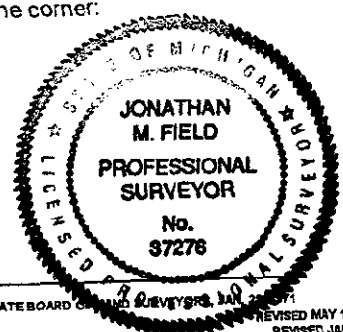

DEER GROUP
 APPROVED LAND CORNER
 PA 345 OF 1990
 LAPEER COUNTY
 RAY DAVIS, S. CO. SURVEYOR
 DATE 9-29-97

LIBER 0005 PAGE 0445

FORM APPROVED BY MICHIGAN STATE BOARD OF LAND SURVEYORS, JAN 2001
 REVISED MAY 14, 1975
 REVISED JAN., 1981
 ADAPTED FOR WORD PROCESSING MARCH, 1993