

# SURVEY & REMONUMENTATION

APR 28 1995

COMMISSION

## 1994 REMONUMENTATION PROGRAM LAND CORNER RECORDATION CERTIFICATE

Filing Requirement of Act 74, Mich. P.A. 1970

RECEIVED FOR RECORD

94 DEC 22 PM 1:58

LIBER NO. 25 PAGE NO. 175  
*Melissa B. Stang*  
REGISTER OF DEEDS  
LAPEER COUNTY, MICHIGAN

For corners in DEERFIELD TWP.  
LAPEER (County) Located In: Corner Code #

1. Public Land Survey	T 09N R 10E	M-6
	T _____ R _____	_____
	T _____ R _____	_____
	T _____ R _____	_____
2. Property Controlling in Section	S _____ T _____ R _____	_____
	S _____ T _____ R _____	_____
3. Miscellaneous Property in Sec.	S _____ T _____ R _____	_____
	S _____ T _____ R _____	_____

4. Lot No. \_\_\_\_\_, Recorded Plat \_\_\_\_\_  
5. Private Claims \_\_\_\_\_

Register of Deeds Stamp & File Number

	A	B	C	D	E	F	G	H	I	J	K	L	M
1													
2	6	5	4	3	2	1							
3													
4	7	8	9	10	11	12							
5													
6	18	17	16	15	14	13							
7													
8	19	20	21	22	23	24							
9													
10	30	29	28	27	26	25							
11													
12	31	32	33	34	35	36							
13													

I, JONATHAN M. FIELD, in a field survey on SEPTEMBER 23 19 94 do hereby certify that under requirements of P.A. 74, Michigan P.A. of 1970, the corner points mentioned in lines 1 and 2 above were in conformance with regulations and rules therefore as required in the current manual of survey instructions of the United States Department of the Interior, Bureau of Land Management or by a decree of a Court of Law and/or that the corner points mentioned in lines 3, 4 and 5 above were in conformance with the rules of the Michigan Board of Land Surveyors or by a Decree of a Court of Law; established, re-established, monumented, re-monumented, recovered, found as expressed below:

NOTE: Not more than 4 corners, all in the same town and range, may be recorded on this certificate.

- A. Description of original monument and accessories and/or subsequent restoration:
- 1822 GLO; WAMPLER, D.S.; SET 1/2 MILE POST; PINE 30 N39 1/2W 32LKS., PINE 30 S70W 24LKS.
  - 1972 KAY ENG.; KAY, P.S.#14096; SURVEY L.1, PG.494; NO OBJECT STATED; N70°W 55.6' 48" OAK, N50°W 53.05' 20" OAK, N40°E 35.01' GATE POST
  - 1974 HENDERSON-BATES; ELRICH, P.S.#18986; SURVEY L.2, PG.668; FND 5/8" ROD; SAME WITS AS 1972 SURVEY ABOVE
  - 1974 ELRICH, P.S.#18986; LCRC L.2, PG.541; FND 5/8" ROD; SAME WITS AS 1972 SURVEY ABOVE
  - 1974 HENDERSON-BATES; HENDERSON, P.S.#16043; SURVEY L.3, PG.748; FND 1/2" ROD; SAME WITS AS 1972 SURVEY ABOVE
  - 1977 BECK-GRAVLIN; GRAVLIN, P.S.#23510; SURVEY L.4, PG.144; SAME WITS AS 1972 SURVEY ABOVE
  - 1979 HENDERSON-BATES; ELRICH, P.S.#18986; SURVEY L.5, PG.417; FND 5/8" IRON; SAME WITS AS 1972 SURVEY ABOVE
  - 1980 BECK-GRAVLIN; GRAVLIN, P.S.#23510; SURVEY L.5, PG.563; NO OBJECT STATED; SAME WITS AS 1972 SURVEY ABOVE
  - 1984 HENDERSON-BATES; ELRICH, P.S.#18986; SURVEY L.6, PG.815; FND 1/2" IRON; SAME WITS AS 1972 SURVEY ABOVE EXCEPT N80°E 27.10' S. GATE POST ADDED

- B. Description of corner evidence found and/or method applied in restoring or reestablishing corner:
- 1994 ROWE ENG.; FIELD, P.S.#37276; FND 1/2" ROD 1' W. OF C/L GRAVEL ROAD N-S & ON FENCE LINE E-W RECOVERED 2 PREVIOUS WITNESSES INDICATING THAT FND ROD IS IN SAME POSITION AS 1972 KAY ENG. SURVEY THIS CORNER HAS BEEN HELD AS COMMON TO T9N-R10E AND T9N-R1E FOR SEVERAL SURVEYS IN BOTH TOWNSHIPS
  - 2640.34' M-6 TO M-7 (MEAS. BY OTHERS)
  - 2638.87' M-6 TO M-5 (MEAS. BY OTHERS)


ACCEPTED 1/2" ROD AS A CAREFUL AND FAITHFUL PERPETUATION OF THE ORIGINAL CORNER POSITION  
LAPEER CO. PEER GROUP ACCEPTED 1/2" ROD AS ALSO BEING A-6 T9N-R1E

C. Description of monument for corner and accessories established to perpetuate locating the position of the corner:

M-6 SET STANDARD BRASS CAP ON 1/2" ROD

- N77°W, 55.44' SET NAIL W/ REMON TAG IN E. FACE TWIN 24" OAK
- N41°W, 52.86' SET NAIL W/ REMON TAG IN NE FACE 22" OAK
- EAST, 25.83' SET NAIL W/ REMON TAG IN N. FACE FE POST
- EAST, 33.00' FND 1/2" ROD W/CAP #18986
- S61°E, 30.16' SET NAIL W/ REMON TAG ABOVE FND NAIL W/FLAG. IN W. FACE 14" MAPLE

PEER GROUP APPROVED LAND CORNER  
PA 345 OF 1990  
*RAY DAVIS* Date 12-8-94  
Surveyor's Michigan License No 37276  
RAY DAVIS P.S. CO. SURVEYOR  
DATE 12-22-94

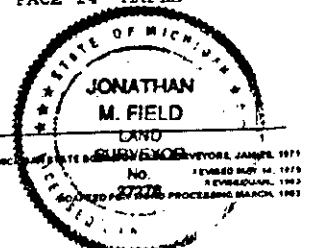

LIBER 0005 PAGE 0175