

SURVEY &
REMONUMENTATION

1993

COMMISSION

REMONUMENTATION
LAND CORNER RECORDATION CERTIFICATE

Filing Requirement of Act 74, Mich. P.A. 1970

RECEIVED FOR RECORD

For corners in

<u>LAPEER</u> (County)		Located In:	Corner Code #
1. Public Land Survey	T <u>9</u> N R <u>10</u> E		<u>M-11</u>
	T _____ R _____		_____
	T _____ R _____		_____
	T _____ R _____		_____
2. Property Controlling in Section	S _____ T _____ R _____		_____
	S _____ T _____ R _____		_____
3. Miscellaneous Property in Sec.	S _____ T _____ R _____		_____
	S _____ T _____ R _____		_____
4. Lot No. _____, Recorded Plat _____			
5. Private Claims _____			

94 JAN - 6 PM 10:55
LIBER # 005 PAGE NO. 62-63
Jonathan M. Field
RECORDS & CLERK
LAND SURVEYOR

Register of Deeds Stamp & File Number

	A	B	C	D	E	F	G	H	I	J	K	L	M
2	6	5	4	3	2	1							
3													
4	7	8	9	10	11	12							
5													
6	18	17	16	15	14	13							
7													
8	19	20	21	22	23	24							
9													
10	30	29	28	27	26	25							
11													
12	31	32	33	34	35	36							
13													

I, Jonathan M. Field, in a field survey on October, 19 93, do hereby certify that under requirements of P.A. 74, Michigan P.A. of 1970, the corner points mentioned in lines 1 and 2 above were in conformance with regulations and rules therefore as required in the current manual of survey instructions of the United States Department of the Interior, Bureau of Land Management or by a decree of a Court of Law and/or that the corner points mentioned in lines 3, 4 and 5 above were in conformance with the rules of the Michigan Board of Land Surveyors or by a Decree of a Court of Law; established, re-established, monumented, re-monumented, recovered, found as expressed below:

NOTE: Not more than 4 corners, all in the same town and range, may be recorded on this certificate.

A. Description of original monument and accessories and/or subsequent restoration:
1822 GLO- Wampler, D.S.; Set post; Pine 20" S5W 20lks., Pine 20" N1W 45lks.
1834 GLO- Subdivision; West btwn Sec.'s 30 & 31 79.15CH Int'd Range line at stake Maple 8" N28E 35lks., Pine 10" S31E 22lks.

1974 Elrich, P.S.#18986; Survey L.3, Pg.76 - Fnd. 1/2" iron
1974 Elrich, P.S.#18986; LCRC L.2, Pg.787 - Fnd. 1/2" iron; same 3 wits as 1974 survey
1974 Kay, P.S.#14096; Survey L.3, Pg.3 - Fnd. 1/2" iron; same wits as 1974 survey
1978 Gravlin, P.S.#23510; Survey L.4, Pg.548 - Fnd. 1/2" iron; same wits as 1974 survey
1978 Gravlin, P.S.#23510; Survey L.4, Pg.672 - 1/2" iron; same wits as 1974 survey


Section A. continued on back

B. Description of corner evidence found and/or method applied in restoring or reestablishing corner:
1993 Rowe Eng. - Field, P.S.#37276; Fnd. 1/2" smooth rod 2.5' E of c/l gravel road N-S and on line w/ fence line to W.
Fnd. 2 previous wits which indicate that rod is in same position as 1974 Elrich survey
Accepted fnd. rod as best evidence of original corner position

C. Description of monument for corner and accessories established to perpetuate locating the position of the corner:
M-11 1/2" rod w/ standard brass cap
N47°E, 29.00' Set nail w/remon tag above fnd nail w/flag. in NW face twin 8" Ash
N78°E, 31.89' Set nail w/remon tag above fnd nail w/flag. in SE face 10" Poplar
S48°W, 31.74' Set nail w/remon tag below fnd nail w/flag. in E. face 36" Maple
West, 67.89' Set nail w/remon tag in S. face P.pole
N31°W, 30.27' Set nail w/remon tag above fnd nail w/flag. in NE face 6" Maple in clump

Signed by *Jonathan M. Field*
Surveyor's Michigan License No. 37276

Date 11-24-93

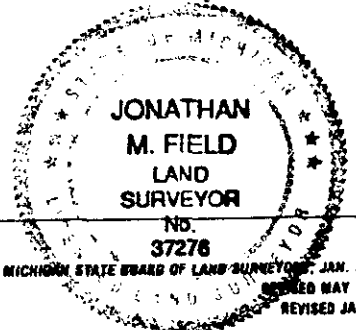

FORM APPROVED BY MICHIGAN STATE BOARD OF LAND SURVEYORS, JAN. 28, 1971
REVISED MAY 14, 1975
REVISED JAN., 1983

Section A. (cont.)

1978 Henderson, P.S.#16043; Survey L.4,Pg.836 - no object stated; same wits as 1974 survey
 1978 Elrich, P.S.#18986; Survey L.5,Pg.316 - 1/2" iron; same wits as 1974 survey
 1986 Henderson, P.S.#16043; Survey L.7,Pg.461 - Fnd. 1/2" iron; same wits as 1974 survey
 1989 Gravlin, P.S.#23510; LCRC L.4,Pg.226 - Fnd 1/2" iron; wits same as 1974 survey
 1991 Gravlin, P.S.#23510; Survey L.9,Pg.542 - Fnd. 1/2" iron; wits same as 1974 survey
 1991 Elrich, P.S.#18986; LCRC L.4,Pg.413 - Fnd. 1/2" iron; 2 prev. wits verify position
 1992 Elrich, P.S.#18986; Survey L.9,Pg.923 - Fnd. 1/2" iron; same wits as 1991 LCRC
 1992 Gravlin, P.S.#23510; Survey L.9,Pg.935 - Fnd. 1/2" iron; 2 prev. wits verify position

2.00	REMOVT
POD75	REMLC
9.00	MISC D