

SURVEY &
REMONUMENTATION

1993

COMMISSION

REMONUMENTATION
LAND CORNER RECORDATION CERTIFICATE
Filing Requirement of Act 74, Mich. P.A. 1970

RECEIVED FOR RECORD

For corners in

LAPEER
(County)

Located In: _____ Corner Code # _____

1. Public Land Survey T 9 N R 10 E M-12
T _____ R _____
T _____ R _____
T _____ R _____

2. Property Controlling S _____ T _____ R _____
in Section S _____ T _____ R _____

3. Miscellaneous S _____ T _____ R _____
Property in Sec. S _____ T _____ R _____

4. Lot No. _____, Recorded Plat _____

5. Private Claims _____

94 JAN -11 PM 12:55
LIBER 005 PAGE 64-65
Jonathan M. Field
RECORDS & CLERK
LAPEER COUNTY MICHIGAN

Register of Deeds Stamp & File Number

I, Jonathan M. Field, in a field survey on October, 1993, do hereby certify that under requirements of P.A. 74, Michigan P.A. of 1970, the corner points mentioned in lines 1 and 2 above were in conformance with regulations and rules therefore as required in the current manual of survey instructions of the United States Department of the Interior, Bureau of Land Management or by a decree of a Court of Law and/or that the corner points mentioned in lines 3, 4 and 5 above were in conformance with the rules of the Michigan Board of Land Surveyors or by a Decree of a Court of Law; established, re-established, monumented, re-monumented, recovered, found as expressed below:

NOTE: Not more than 4 corners, all in the same town and range, may be recorded on this certificate.

	A	B	C	D	E	F	G	H	I	J	K	L	M
2	6	5	4	3	2	1							
3													
4	7	8	9	10	11	12							
5													
6	18	17	16	15	14	13							
7													
8	19	20	21	22	23	24							
9													
10	30	29	28	27	26	25							
11													
12	31	32	33	34	35	36							
13													

A. Description of original monument and accessories and/or subsequent restoration:

- 1822 GLO- Wampler, D.S.; Set 1/2 mile post; Beech 18" N74 1/2 W 6 1/2 lks., Pine 26" N9W 261ks.
- 1906 Sickledsted, C.S.; Stake, Pine 34" S63E 67lks., Pine 30" N30E 70lks.
- 1992 Elrich, P.S.#18986; Survey L.10, Pg.85 - Fnd. 1/2" iron
- NOTE:** Witnesses to A-12, T9N-R11E indicate that it is common with M-12, T9N-R10E :
- 1973 Henderson, P.S.#16043; LCRC L.2, Pg.275 - Fnd. iron
- 1974 Kay, P.S.#14096; Survey L.3, Pg.3 - Fnd. 1/2" iron; 3 wits same as 1973 LCRC
- 1974 Kay, P.S.#14096; Survey L.3, Pg.54 - Fnd. 1/2" iron 3 wits same as 1973 LCRC
- 1978 Elrich, P.S.#18986; Survey L.4, Pg.569 - Fnd. 1/2" iron; wits same as 1973 LCRC
- 1980 Elrich, P.S.#18986; Survey L.5, Pg.933 - Fnd. 1/2" iron; 2 wits same as 1973 LCRC


Section A. continued on back

B. Description of corner evidence found and/or method applied in restoring or reestablishing corner:

- 1993 Rowe Eng. - Field, P.S.#37276; Fnd. 1/2" rod 3'W & 6'S of c/l intersection of gravel roads N-S-E and on line w/ tree row to W.
- Fnd. 2 previous wits which indicate that 1/2" rod is in same position as 1973 LCRC
- Accepted fnd. rod as best evidence of original corner position

C. Description of monument for corner and accessories established to perpetuate locating the position of the corner:

- M-12 1/2" rod w/ standard brass cap
- N41°E, 51.34' Set nail w/remon tag above fnd 40d nail w/flag. in SE face P.pole
- N86°W, 52.15' Set nail w/remon tag above fnd 40d nail w/flag. in S. face P.pole
- S12°W, 122.32' Set nail w/remon tag in NW face 16" Oak
- S55°E, 38.84' Top center of large phone riser
- N25°W, 123.14' Set nail w/remon tag in E. face P.pole
- S66°E, 58.24' Set nail w/remon tag in NE face 10" Maple

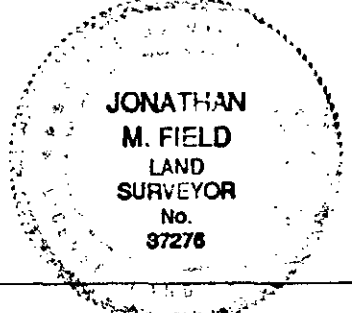

Signed by Jonathan M. Field Date 11-24-93
Surveyor's Michigan License No. 37276

Section A. (cont.)

1983 Gravlin, P.S.#23510; Survey L.6,Pg.743 - 1/2" iron; 3 wits same as 1973 LCRC
1986 Henderson, P.S.#16043; Survey L.7,Pg.461 - no object stated; 2 wits same as 1973 LCRC
1992 Gravlin, P.S.#23510; Survey L.9,Pg.935 - no object stated; 2 wits same as 1973 LCRC

2.00 REMOVT
80075 REMLE
9.00 MISC D