

SURVEY & REMONUMENTATION

APR 29 1996

COMMISSION LAND CORNER RECORDATION CERTIFICATE RECEIVED FOR RECORD

Filing Requirement of Act 74, Mich. P.A. 1970
1995 REMONUMENTATION PROGRAM

95 DEC 13 AM 8:54

For corners in NORTH BRANCH TWP.

<u>LAPEER</u> <small>(County)</small>	Located In:	Corner Code #
1. Public Land Survey	T 09N R 11E	A-5
	T _____ R _____	_____
	T _____ R _____	_____
	T _____ R _____	_____
2. Property Controlling in Section	S _____ T _____ R _____	_____
	S _____ T _____ R _____	_____
3. Miscellaneous Property in Sec.	S _____ T _____ R _____	_____
	S _____ T _____ R _____	_____

LIBER NO. 5 PAGE NO. 315
Heber D. Laugh
REGISTER OF DEEDS
LAPEER COUNTY MICHIGAN

Register of Deeds Stamp & File Number

4. Lot No. _____, Recorded Plat _____
5. Private Claims _____

I, JONATHAN M. FIELD, in a field survey on MARCH 1995
do hereby certify that under requirements of P.A. 74, Michigan P.A. of 1970, the corner points mentioned
in lines 1 and 2 above were in conformance with regulations and rules therefore as required in the
current manual of survey instructions of the United States Department of the Interior, Bureau of Land
Management or by a decree of a Court of Law and/or that the corner points mentioned in lines 3, 4 and 5
above are in conformance with the rules of the Michigan Board of Land Surveyors or by a Decree of a
Court of Law, established, re-established, monumented, re-monumented, recovered, found as
expressed below:

NOTE: Not more than 4 corners, all in the same town and range, may be recorded
on this certificate.

	A	B	C	D	E	F	G	H	I	J	K	L	M
1													
2	6	5	4	3	2	1							
3													
4	7	8	9	10	11	12							
5													
6	18	17	16	15	14	13							
7													
8	19	20	21	22	23	24							
9													
10	30	29	28	27	26	25							
11													
12	31	32	33	34	35	36							
13													

A. Description of original monument and accessories and/or subsequent restoration:

- 1822 GLO; WAMPLER, D.S.; SET POST; BEECH 7 N39W 27LKS., BEECH 14 S80W 46LKS.
- 1899 SICKLESTEEL, C.S.; SURVEY OF SEC.12; NO OBJECT STATED; NO WITS GIVEN
- 1906 SICKLESTEEL, C.S.; SURVEY OF SEC.13; NO OBJECT STATED; NO WITS GIVEN
- 1972 KAY ENG.; KAY, P.S.#14096; SURVEY L.1, PG.494; NO OBJECT STATED; S60W 107.2' 14" POPLAR, S40W 58.0' T.POLE; S30E 54.1' COR. POST
- 1982 GRAVLIN, P.S.#23510; SURVEY L.6, PG.359; NO OBJECT STATED; SAME WITS AS 1972 SURVEY
- 1989 GRAVLIN, P.S.#23510; LCRC L.4, PG.224; FND IRON; SAME WITS AS 1972 SURVEY ABOVE
- 1989 GRAVLIN, P.S.#23510; SURVEY L.8, PG.707; FND 1/2" IRON; SAME WITS AS 1972 SURVEY ABOVE
- 1992 GRAVLIN, P.S.#23510; SURVEY L.9, PG.701; FND 1/2" ROD; N05W 33.55' COR. POST, S50E 57.47' COR. POST, N50E 70.15' 6" POPLAR
- 1993 GRAVLIN, P.S.#23510; SURVEY L.10, PG.254; FND 1/2" ROD; SAME WITS AS 1992 SURVEY ABOVE
- 1994 GRAVLIN, P.S.#23510; SURVEY L.10, PG.510; FND 1/2" ROD; SAME WITS AS 1992 SURVEY ABOVE
- 1994 GRAVLIN, P.S.#23510; SURVEY L.10, PG.836; FND 1/2" ROD; SAME WITS AS 1992 SURVEY ABOVE

B. Description of corner evidence found and/or method applied in restoring or reestablishing corner:

- 1994 ROWE ENG.; FIELD, P.S.#37276; FND 1/2" ROD 5'W. OF C/L GRAVEL ROAD TO S. AND INLINE WITH TREE ROW TO N. ALSO FND 3 WITS GIVEN BY GRAVLIN IN 1992 INDICATING THAT FND IRON IS IN SAME POSITION


G.L.O. NOTES FOR T9N-R11E INDICATE THAT THIS CORNER IS COMMON WITH M-5 T9N-R10E

M-5 TO M-4 2626.14' (REI 1995)	M-5 TO L-5 2647.52 (REI 1995)
M-5 TO M-6 2638.80' (REI 1995)	2647.49 (GRAVLIN 1989)
2638.88' (GRAVLIN 1994)	
2638.86' (GRAVLIN 1992)	

ACCEPTED FND ROD AS A CAREFUL AND FAITHFUL PERPETUATION OF THE ORIGINAL CORNER POSITION

C. Description of monument for corner and accessories established to perpetuate locating the position of the corner:

- A-5 SET 1/2"X 18" ROD W/ STANDARD BRASS CAP IN MON. BOX
- N05°W, 33.53' FND P-K NAIL W/FLAG. E. FACE 6" FENCE POST
- N50°E, 70.16' FND NAIL W/FLAG. S. FACE TRIPLE 4" POPLAR
- S50°E, 57.50' FND NAIL W/FLAG. N. FACE 8" FENCE POST
- S45°E, 53.08' FND P-K NAIL W/FLAG. W. FACE 8" STUMP
- S40°W, 57.34' TOP CENTER OF PHONE RISER
- NORTH, 2.00' SET P-K NAIL
- EAST, 2.00' SET P-K NAIL

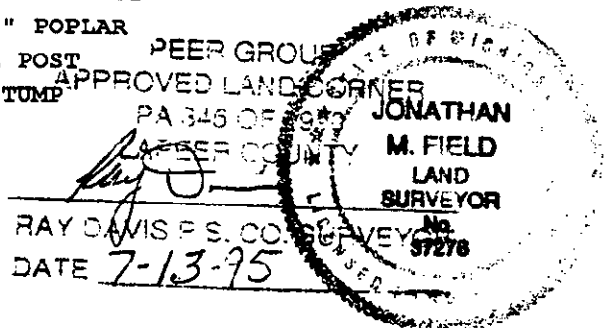

Signed by *Jonathan M. Field*
Surveyor's Michigan License No. 37276

Date 12-1-95