

MAR 23 2000

REMONUMENTATION

SECTION

LAND CORNER RECORDATION CERTIFICATE  
Filing Requirement of Act 74, Mich. P.A. 1970

RECEIVED FOR RECORD

99 DEC 14 AM 9:17

For corners in

Lapeer (County)	Located In: North Branch Twp.	Corner Code #
1. Public Land Survey	T 9N R 11E	A-12
	T R	
	T R	
	T R	
2. Property Controlling in Section	S T R	
	S T R	
3. Miscellaneous Property in Sec.	S T R	
	S T R	

Melissa DeVaugh  
REGISTER OF DEEDS  
LAPPEER COUNTY, MICHIGAN

528

Register of Deeds Stamp & File Number

- 4. Lot No. \_\_\_\_\_, Recorded Plat \_\_\_\_\_
- 5. Private Claims \_\_\_\_\_

A B C D E F G H I J K L M

1													
2	6	5	4	3	2	1							
3													
4	7	8	9	10	11	12							
5													
6	18	17	16	15	14	13							
7													
8	19	20	21	22	23	24							
9													
10	30	29	28	27	26	25							
11													
12	31	32	33	34	35	36							
13													

I, Earl E. Gravlin, in a field survey on July 23 19 99, do hereby certify that under requirements of P.A. 74, Michigan P.A. of 1970, the corner points mentioned in lines 1 and 2 above were in conformance with regulations and rules therefore as required in the current manual of survey instructions of the United States Department of the Interior, Bureau of Land Management or by a decree of a Court of Law and/or that the corner points mentioned in lines 3, 4 and 5 above were in conformance with the rules of the Michigan Board of Land Surveyors or by a Decree of a Court of Law, established, re-established, monumented, re-monumented, recovered, found as expressed below:

NOTE: Not more than 4 corners, all in the same town and range, may be recorded on this certificate.


A. Description of original monument and accessories and/or subsequent restoration:  
GLO: not set. County Surveyor: nothing. 1973 Henderson L2 P275-276 Act 74, found iron, NW 77.83' 10" maple, NE 45.53' road sign, SE 39.45' pp, SW 122.45' 14" maple. 1974 Kay L3 P3-4, N45E 45.53' road sign, N35W 77.83' 10" maple, S30W 122.45' 14" maple, fnd 1/2" iron. 1974 Kay job #74-260, same as L3 P3-4. 1974 Kay L3 P54, same as L3 P3-4. 1978 Elrich L4 P569, same as L3 P275-276. 1980 Elrich L5 P933, N40E 51.36' pp, N85W 52.25' pp, S40E 39.45' tp, S20W 122.45' 18" maple. 1983 Gravlin L6 P743, same as L3 P3-4. 1986 Henderson L7 P461, same as L5 P933. 1992 Gravlin L9 P935-936, same as L5 P933. 1993 Gravlin L10 P152, same as L5 P933. 1993 Field L5 P64 Act 74, 1/2" rod w/standard brass cap, N41E 51.34' set nail w/remon tag above fnd 40d nail w/flag SE face pp, N86W 52.15' set nail w/remon tag above fnd 40d nail w/flag S face pp, S12W 122.32' set nail w/remon tag NW face 16" oak, S55E 38.84' top cen of tele riser, N25W 123.14' set nail w/remon tag E face pp, S66E 58.24' set nail w/remon tag NE face 10" maple. 1993 Gravlin L12 P239, fnd 1/2" iron w/brass cap, N41E 51.34' nail & tag SE face pp, N86W 52.15' nail & tag S face pp, S12W 122.32' nail & tag NW face 16" oak, S55E 38.84' top cen large tele riser, N25W 123.14' nail & tag E face pp, S66E 58.24' nail & tag NE face 10" maple.

PEER GROUP  
APPROVED LAND CORNER  
PA 345 OF 1680  
LAPPEER COUNTY

B. Description of corner evidence found and/or method applied in restoring or reestablishing corner:  
Found standard brass cap on 1/2" iron on centerline of road.  
Witnesses match M-12 T9N-R10E except phone riser is gone.  
Accepted rod as a perpetuation of original corner.  
M-12 T9N-R10E common to A-12.  
A-12 to A-11 2629.10'  
A-12 to A-13 2635.69'

RAY DAVIS P.S. CO. SURVEY.  
DATE 12-21-99

C. Description of monument for corner and accessories established to perpetuate locating the position of the corner:  
A-12 West quarter corner section 31, East quarter corner section 36 T9N-R10E  
Found standard brass cap on 1/2" rod  
N41E 51.34' set nail w/remon tag above fnd 40d nail w/flag SE face pp  
N86W 52.15' set nail w/remon tag above fnd 40d nail w/flag S face pp  
S12W 122.32' set nail w/remon tag NW face 16" oak  
N25W 123.14' set nail w/remon tag E face pp  
S66E 58.24' set nail w/remon tag NE face 10" maple

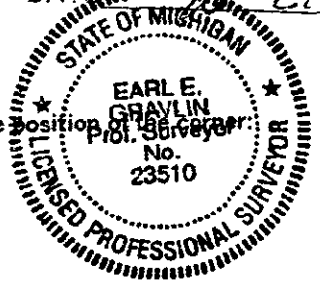

Signed by [Signature] Date DEC 2-1999  
Surveyor's Michigan License No. 23510

FORM APPROVED BY MICHIGAN STATE BOARD OF LAND SURVEYORS, JAN. 25, 1971

REVISED MAY 14, 1975  
REVISED JAN. 1983  
ADAPTED FOR WORD PROCESSING MARCH, 1993