

MAR 23 2000

REMONUMENTATION

SECTION

LAND CORNER RECORDATION CERTIFICATE

Filing Requirement of Act 74, Mich. P.A. 1970

For corners in

RECEIVED FOR RECORD
 99 DEC 14 AM 9:17

<u>Lapeer</u> (County)	Located In: North Branch Twp.	Corner Code # A-13
1. Public Land Survey	T 9N R 11E	
	T _____ R _____	
	T _____ R _____	
	T _____ R _____	
2. Property Controlling in Section	S _____ T _____ R _____	
	S _____ T _____ R _____	
3. Miscellaneous Property in Sec.	S _____ T _____ R _____	
	S _____ T _____ R _____	

Melissa De Vaughn
 REGISTER OF DEEDS
 LAPEER COUNTY MICHIGAN

529

Register of Deeds Stamp & File Number

4. Lot No. _____, Recorded Plat _____
 5. Private Claims _____

A B C D E F G H I J K L M

1														
2	6	5	4	3	2	1								
3														
4	7	8	9	10	11	12								
5														
6	18	17	16	15	14	13								
7														
8	19	20	21	22	23	24								
9														
10	30	29	28	27	26	25								
11														
12	31	32	33	34	35	36								
13														

I, Earl E. Gravlin, in a field survey on July 23 19 99, do hereby certify that under requirements of P.A. 74, Michigan P.A. of 1970, the corner points mentioned in lines 1 and 2 above were in conformance with regulations and rules therefore as required in the current manual of survey instructions of the United States Department of the Interior, Bureau of Land Management or by a decree of a Court of Law and/or that the corner points mentioned in lines 3, 4 and 5 above were in conformance with the rules of the Michigan Board of Land Surveyors or by a Decree of a Court of Law, established, re-established, monumented, re-monumented, recovered, found as expressed below:

NOTE: Not more than 4 corners, all in the same town and range, may be recorded on this certificate.

A. Description of original monument and accessories and/or subsequent restoration:

GLO: not set. County Surveyor: nothing. 1973 Henderson L2 P275-276 Act 74, find rerod, North 45.45' 10" maple, NE 34.5' 24" maple, SE 36.3' rod on prop cor, SW 49.5' SE cor concrete top CMP, NW 50.7' scam top 60" CMP. 1978 Elrich L4 P569, same as L2 P279. 1993 Field L5 P66, 1/2" rod w/standard brass cap, N02E 45.40' set nail w/remon tag above find nail w/flag W face 10" maple, N58E 34.49' set nail w/remon tag above find nail above find PK nail w/flag S face 30" maple, N35W 28.30' set nail w/remon tag above find PK nail w/disc in SW face 8" elm, S43E 31.75' find PK nail w/disc in NE corn of 6x8 wood fnc cor post fnc S-E-W, N72W 72.42' set nail w/remon tag S face 10" maple, North 33.00' find 1/2" rod w/cap #18986, West 50+/- centerline of creek.

B. Description of corner evidence found and/or method applied in restoring or re-establishing corner:

Found standard brass cap on 1/2" iron on centerline of road.
 Witnesses match M-13 T9N-R10E.
 Accepted rod as a perpetuation of original corner.
 M-13 T9N-R10E, A-1 T8N-R11E, M-1 T8N-R10E common to A-13.
 A-13 to A-12 2635.69'


APPROVED LAND CORNER
 PA 845 OF 1990
 LAPEER COUNTY

RAY DAVIS P.S. CO. SURVEYOR
 DATE 10-21-99



C. Description of monument for corner and accessories established to perpetuate locating the position of the corner:

A-13 section corner section 31
 Found standard brass cap on 1/2" rod
 N02E 45.40' set nail w/remon tag above find nail w/flag W face 10" maple
 N58E 34.49' set nail w/remon tag above find nail above find PK nail w/flag S face 30" maple
 N35W 28.30' set nail w/remon tag above find PK nail w/disc in SW face 8" elm
 S43E 31.75' find PK nail w/disc in NE corn of 6x8 wood fnc cor post fnc S-E-W
 N72W 72.42' set nail w/remon tag S face 10" maple
 North 33.00' find 1/2" rod w/cap #18986
 West 50+/- centerline of creek

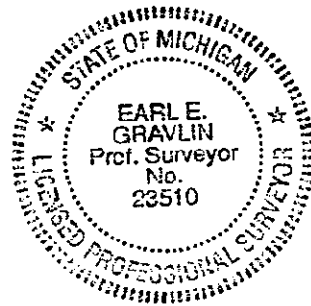

Signed by [Signature]
 Surveyor's Michigan License No. 23510

Date DEC 3 1999

FORM APPROVED BY MICHIGAN STATE BOARD OF LAND SURVEYORS, JAN. 28, 1973

REVISED MAY 24, 1975
 REVISED JAN. 1983