

**SURVEY & REMONUMENTATION**

OCT 29 1996

COMMISSION

REMONUMENTATION

**LAND CORNER RECORDATION CERTIFICATE**  
 Filing Requirement of Act 74, Mich. P.A. 1970

RECEIVED RECORD

96 SEP 30 PM 3:06

For corners in

LAPEER <small>(County)</small>	Located In:	Corner Code ##
	9N 11E	M-2
1. Public Land Survey	T ___ R ___	_____
	T ___ R ___	_____
	T ___ R ___	_____
	T ___ R ___	_____
2. Property Controlling in Section	S ___ T ___ R ___	_____
	S ___ T ___ R ___	_____
3. Miscellaneous Property in Sec.	S ___ T ___ R ___	_____
	S ___ T ___ R ___	_____

*Ray David*  
 REGISTER OF DEEDS  
 LAPEER COUNTY

Register of Deeds Stamp & File Number

- 4. Lot No. \_\_\_\_\_, Recorded Plat \_\_\_\_\_
- 5. Private Claims \_\_\_\_\_

	A	B	C	D	E	F	G	H	I	J	K	L	M
2	6		5		4		3		2		1		
3													
4	7		8		9		10		11		12		
5													
6	18		17		16		15		14		13		
7													
8	19		20		21		22		23		24		
9													
10	30		29		28		27		26		25		
11													
12	31		32		33		34		35		36		
13													

I, EARL E. GRAVLIN in a field survey on AUGUST, 1996, do hereby certify that under requirements of P.A. 74, Michigan P.A. of 1970, the corner points mentioned in lines 1 and 2 above were in conformance with regulations and rules therefore as required in the current manual of survey instructions of the United States Department of the Interior, Bureau of Land Management or by a decree of a Court of Law and/or that the corner points mentioned in lines 3, 4 and 5 above were in conformance with the rules of the Michigan Board of Land Surveyors or by a Decree of a Court of Law; established, re-established, monumented, re-monumented, recovered, found as expressed below:

**NOTE: Not more than 4 corners, all in the same town and range, may be recorded on this certificate.**

A. Description of original monument and accessories and/or subsequent restoration:

History: Wampler, 1822, set 1/2 mile post, Beech 9 N.5W. 21, Do. 9 N.69W. 32. County Surveyor Book 2, page 57 Stone 19.14.12 stake. Act 74 none. Recorded surveys, Liber 006, page 231-234, Found 1" Hex Bar in Mon Box, N10°W 61.15' Nail Fence Post, North 56.05' Nail in PP, South 51.8' Nail 8" Thornapple. MDOT M-2 to A-2 126.69, M-2 to M-3 2640.59


B. Description of corner evidence found and/or method applied in restoring or reestablishing corner:

Found 1" Iron Bar in Mon Box, centerline of M-90.  
 M-1 TO M-2 3181.24 AND M-2 TO M-3 2640.36 M-2 to A-2 126.65

PEER GROUP  
 APPROVED LAND CORNER  
 PA 345 OF 1990  
 LAPEER COUNTY  
*Ray David*  
 RAY DAVID P.S. CO. SURVEYOR  
 DATE 9-10-96

C. Description of monument for corner and accessories established to perpetuate locating the position of the corner:

M-2 EAST 1/4 CORNER, SECTION 1, T9N-R11E  
 FOUND 1" IRON BAR IN MON BOX CENTERLINE M-90, REPLACED WITH 1/2" IRON AND BRASS GAP  
 NORTH 56.54' NAIL AND TAG W/S POWER POLE  
 N10°W 59.01' FACE CABLE SIGN  
 N40°E 84.52' NAIL AND TAG W/S 4" ELM  
 S40°W 63.35' NAIL AND TAG E/S 5" ASH

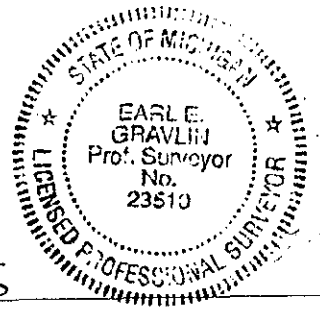

Signed by *Earl E. Gravlins* Date 9-10-96  
 Surveyor's Michigan License No. 23510