

SURVEY &  
REMONUMENTATION

1993

COMMISSION

REMONUMENTATION  
LAND CORNER RECORDATION CERTIFICATE  
Filing Requirement of Act 74, Mich. P.A. 1970

RECEIVED FOR RECORD

93 DEC 22 PM 3:14

LIBER 5 FILE NO. 43


For corners in

LAPEER  
(County)

Located In:

Corner Code #

- 1. Public Land Survey      T 9N R 11E      M-12  
    T \_\_\_\_\_ R \_\_\_\_\_  
    T \_\_\_\_\_ R \_\_\_\_\_  
    T \_\_\_\_\_ R \_\_\_\_\_
- 2. Property Controlling    S \_\_\_\_\_ T \_\_\_\_\_ R \_\_\_\_\_  
    in Section                    S \_\_\_\_\_ T \_\_\_\_\_ R \_\_\_\_\_
- 3. Miscellaneous            S \_\_\_\_\_ T \_\_\_\_\_ R \_\_\_\_\_  
    Property in Sec.            S \_\_\_\_\_ T \_\_\_\_\_ R \_\_\_\_\_
- 4. Lot No. \_\_\_\_\_, Recorded Plat \_\_\_\_\_
- 5. Private Claims \_\_\_\_\_

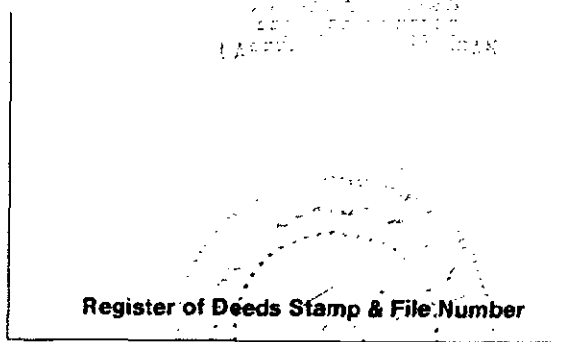

	A	B	C	D	E	F	G	H	I	J	K	L	M
2	6	5	4	3	2	1							
3													
4	7	8	9	10	11	12							
5													
6	18	17	16	15	14	13							
7													
8	19	20	21	22	23	24							
9													
10	30	29	28	27	26	25							
11													
12	31	32	33	34	35	36							
13													

I, Earl E. Gravlin, in a field survey on October, 19 93, do hereby certify that under requirements of P.A. 74, Michigan P.A. of 1970, the corner points mentioned in lines 1 and 2 above were in conformance with regulations and rules therefore as required in the current manual of survey instructions of the United States Department of the Interior, Bureau of Land Management or by a decree of a Court of Law and/or that the corner points mentioned in lines 3, 4 and 5 above were in conformance with the rules of the Michigan Board of Land Surveyors or by a Decree of a Court of Law; established, re-established, monumented, re-monumented, recovered, found as expressed below:

**NOTE: Not more than 4 corners, all in the same town and range, may be recorded on this certificate.**

A. Description of original monument and accessories and/or subsequent restoration:

History: East and South and West town lines run by Joseph Wampler, 1821. Pages 445 and 447. Subdivision of township run by Hiram Burnham, second quarter, 1834. page 455. Witnesses: Elm 20 N57°W .38, Do 32 S61 1/2°W .38 Post set County Surveyors Record: Nothing in NE or SE 1/4. Recorded surveys L002 P201 Kay 1973 references East 1/4 corner No witnesses.

B. Description of corner evidence found and/or method applied in restoring or reestablishing corner:

Site conditions: Farmland slightly rolling Summers road (gravel)  
 Set 1/2" iron by single proration  
 Occupation to west, faint line of soil discoloration split falls within line.  
 Fence to West 1326' south.  
 MEASUREMENT M-12 TO M-13 2628.98', M-12 TO M-11 2628.97'

C. Description of monument for corner and accessories established to perpetuate locating the position of the corner:

November 11, 1993  
 M-12  
 Set 1/2" iron with brass cap by single proration.  
 A-12 T9N-R12E 1/2" Iron 7.57' North  
 N89°W 59.25' NAIL & TAG N SIDE POWER POLE  
 N17°E 79.31' NAIL & TAG W SIDE 24" MAPLE  
 N50°E 30.41' NAIL & TAG N SIDE 12" BOX ELDER  
 S36°E 45.07' NAIL & TAG E SIDE 8" BOX ELDER



Signed by [Signature] Date 12/02/93

Surveyor's Michigan License No. 23510