

REMONUMENTATION

MAR 29 1999

LAND CORNER RECORDATION CERTIFICATE  
Filing Requirement of Act 74, Mich. P.A. 1970

RECEIVED FOR RECORD

98 NOV 25 AM 9:22

For corners in LAPEER

SECTION

Located In: Corner Code #/

1. Public Land Survey Located In: BURNSIDE SOUTH Corner Code #/ A-2  
 T 9N R 12E  
 T \_\_\_\_\_ R \_\_\_\_\_  
 T \_\_\_\_\_ R \_\_\_\_\_  
 T \_\_\_\_\_ R \_\_\_\_\_
2. Property Controlling in Section S \_\_\_\_\_ T \_\_\_\_\_ R \_\_\_\_\_  
 S \_\_\_\_\_ T \_\_\_\_\_ R \_\_\_\_\_
3. Miscellaneous Property in Sec. S \_\_\_\_\_ T \_\_\_\_\_ R \_\_\_\_\_  
 S \_\_\_\_\_ T \_\_\_\_\_ R \_\_\_\_\_
4. Lot No. \_\_\_\_\_, Recorded Plat \_\_\_\_\_
5. Private Claims \_\_\_\_\_

407

Melissa DeVaugh  
REGISTER OF DEEDS  
LAPEER COUNTY, MICHIGAN

Register of Deeds Stamp & File Number

|    |    |    |    |    |    |    |   |   |   |   |   |   |   |
|----|----|----|----|----|----|----|---|---|---|---|---|---|---|
|    | A  | B  | C  | D  | E  | F  | G | H | I | J | K | L | M |
| 2  | 6  | 5  | 4  | 3  | 2  |    |   |   |   |   |   |   |   |
| 3  |    |    |    |    |    |    |   |   |   |   |   |   |   |
| 4  | 7  | 8  | 9  | 10 | 11 | 12 |   |   |   |   |   |   |   |
| 5  |    |    |    |    |    |    |   |   |   |   |   |   |   |
| 6  | 18 | 17 | 16 | 15 | 14 | 13 |   |   |   |   |   |   |   |
| 7  |    |    |    |    |    |    |   |   |   |   |   |   |   |
| 8  | 19 | 20 | 21 | 22 | 23 | 24 |   |   |   |   |   |   |   |
| 9  |    |    |    |    |    |    |   |   |   |   |   |   |   |
| 10 | 30 | 29 | 28 | 27 | 26 | 25 |   |   |   |   |   |   |   |
| 11 |    |    |    |    |    |    |   |   |   |   |   |   |   |
| 12 | 31 | 32 | 33 | 34 | 35 | 36 |   |   |   |   |   |   |   |
| 13 |    |    |    |    |    |    |   |   |   |   |   |   |   |

I, Earl E. Gravlin, in a field survey on July 15, 19 98, do hereby certify that under requirements of P.A. 74, Michigan P.A. of 1970, the corner points mentioned in lines 1 and 2 above were in conformance with regulations and rules therefore as required in the current manual of survey instructions of the United States Department of the Interior, Bureau of Land Management or by a decree of a Court of Law and/or that the corner points mentioned in lines 3, 4 and 5 above were in conformance with the rules of the Michigan Board of Land Surveyors or by a Decree of a Court of Law; established, re-established, monumented, re-monumented, recovered, found as expressed below:

NOTE: Not more than 4 corners, all in the same town and range, may be recorded on this certificate.

A. Description of original monument and accessories and/or subsequent restoration:  
History: 1821 West line run by Joseph Wampler. 1834 Subdivision of township by Hiram Burnham. No corner set. County Surveyor Record: Book 2 1868 stone 23-14-8, Pine 30, S 7 1/2 W 123, Pine S 19 1/2 W 100, A-2 to A-3 40.18 (2651.88) A-2 to A-1 46.11 (3043.26). Act 74 none. Recorded surveys, Kay L006 P232, Fd 1/2" iron, South 126.69 1" hex bar in Mon box, S10W 66.40 nail fnc post, North 8.88 Nail 8" apple. Road Commission Nothing. MDOT M-2 to A-2 126.69 Gravlin M-2 to A-2 126.65

B. Description of corner evidence found and/or method applied in restoring or reestablishing corner:


Site Conditions: North line of M-90 right of way, found 1/2" iron. A-2 to M-2 South 126.65 A-2 to A-1 3054.59 A-2 to A-3 2630.50. Tree row to North & South.

PEER GROUP  
APPROVED LAND CORNER  
PA 345 OF 1990  
LAPEER COUNTY

RAY DAVIS P.S. CO. SURVEYOR  
DATE 9-17-98

C. Description of monument for corner and accessories established to perpetuate locating the position of the corner:

NOVEMBER 9, 1998  
FOUND 1/2" RE-ROD IN PLACE, SET BRASS CAP  
N03°E 8.77' NAIL & TAG WEST SIDE 8" APPLE  
S06°W 66.42' NAIL & TAG EAST SIDE WOOD POST  
S47°W 118.76' NAIL & TAG EAST SIDE 6" ELM  
S01°W 70.22' NAIL & TAG WEST SIDE POWER POLE  
S42°E 90.41' NAIL & TAG WEST SIDE 4" ELM  
SOUTH 126.65' A-2

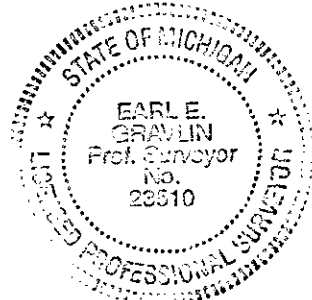

Signed by [Signature] Date 11-16-98  
Surveyor's Michigan License No. 23510