

MAR 29 1999

REMONUMENTATION

SECTION

LAND CORNER RECORDATION CERTIFICATE
Filing Requirement of Act 74, Mich. P.A. 1970

RECEIVED FOR RECORD
98 NOV 25 AM 9: 23

For corners in
LAPEER

(County)

Located In: Corner Code #

	BURNSIDE SOUTH		
1. Public Land Survey	T 9N	R 12E	A-5
	T	R	
	T	R	
	T	R	
2. Property Controlling in Section	S	T	R
	S	T	R
3. Miscellaneous Property in Sec.	S	T	R
	S	T	R

4. Lot No. _____, Recorded Plat _____
5. Private Claims _____

Earl E. Gravlin, in a field survey on July 15, 19 98

I do hereby certify that under requirements of P.A. 74, Michigan P.A. of 1970, the corner points mentioned in lines 1 and 2 above were in conformance with regulations and rules therefore as required in the current manual of survey instructions of the United States Department of the Interior, Bureau of Land Management or by a decree of a Court of Law and/or that the corner points mentioned in lines 3, 4 and 5 above were in conformance with the rules of the Michigan Board of Land Surveyors or by a Decree of a Court of Law; established, re-established, monumented, re-monumented, recovered, found as expressed below:

NOTE: Not more than 4 corners, all in the same town and range, may be recorded on this certificate.

A. Description of original monument and accessories and/or subsequent restoration:

History: 1821 West line run by Joseph Wampler. 1834 Subdivision of township by Hiram Burnham. Intersect Range Line 162 L (106.92) North Set Post Cor to 7 & 18 Beech 18 In dia S42E 19 do 10 In dia N44W 22. County Surveyor Record: Book 2 1866 & 1873 stake set Pine 36, S18 1/2E 52 1/2, Pine 36 S30W 68 1/2, A-5 to A-6 39.86 (2630.76). Act 74 none. Recorded surveys, Gravlin L008 P832, Fd 1" Pipe, East 0.75 E Leg Sign Post, N 40 E 7.53 6" Cherry, N05W 64.78 P.P. Unrecorded Surveys, Kay, Date 7-2-86, Project No 85-63, Fd 2" bar N 64.97 Nail P.P., N30E 7.07 Nail 8" Cherry, S 28.9 to centerline of road. Road Commission Nothing. Gravlin A-5 to A-6 2631.15, Kay A-5 to A-4 2653.86, Kay M-5 to A-5 North 110.20, Gravlin M-5 to A-5 110.12

B. Description of corner evidence found and/or method applied in restoring or reestablishing corner:


Site Conditions: Rolling Farmland, Found 2" bar 30± feet North of C/L Burnside Road East-West, Summers Road gravel to South, tree row to North, A-5 to A-6 2631.14, A-5 to A-4 2653.86, M-5 to A-5 North 110.20. Corner is 3.82± East of the line between M-5 & M-4.

PEER GROUP
APPROVED LAND CORNER
PA 848 OF 1990
LAPEER COUNTY

RAY DAVIS P.S. CO. SURVEYOR
DATE 9-17-98

C. Description of monument for corner and accessories established to perpetuate locating the position of the corner:

NOVEMBER 9, 1998
SET 1/2" RE-ROD OVER 2" BAR, SET BRASS CAP
N24°W 69.89' NAIL & TAG WEST SIDE POWER POLE
S25°W 136.44' NAIL & TAG NORTH SIDE POWER POLE
S08°E 192.71' NAIL & TAG WEST SIDE 24" MAPLE
S08°W 175.33' NAIL & TAG EAST SIDE 26" PINE
SOUTH 110.20' M-5
SOUTH 30' TO CENTERLINE ROAD
EAST 0.27' WEST LEG SIGN

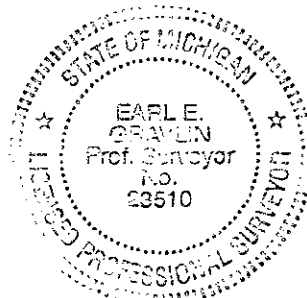

Signed by [Signature] Date 11-16-98
Surveyor's Michigan License No. 23510