

MAR 29 1999

REMONUMENTATION

SECTION

LAND CORNER RECORDATION CERTIFICATE
Filing Requirement of Act 74, Mich. P.A. 1970

RECEIVED FOR RECORD

98 NOV 25 AM 9:24

For corners in
LAPEER

(County)

Located In: Corner Code #/

BURNSIDE SOUTH

1. Public Land Survey	T	9N	R	12E	A-6
	T		R		
	T		R		
	T		R		
2. Property Controlling in Section	S		T	R	
	S		T	R	
3. Miscellaneous Property in Sec.	S		T	R	
	S		T	R	

Melissa DeVaugh
REGISTER OF DEEDS
LAPEER COUNTY, MICHIGAN

409

Register of Deeds Stamp & File Number

4. Lot No. _____, Recorded Plat _____
5. Private Claims _____

A	B	C	D	E	F	G	H	I	J	K	L	M
2	6	5	4	3	2							
3												
4	7	8	9	10	11	12						
5												
6	18	17	16	15	14	13						
7												
8	19	20	21	22	23	24						
9												
10	30	29	28	27	26	25						
11												
12	31	32	33	34	35	36						
13												

Earl E. Gravlin, in a field survey on July 15, 1998

I hereby certify that under requirements of P.A. 74, Michigan P.A. of 1970, the corner points mentioned in lines 1 and 2 above were in conformance with regulations and rules therefore as required in the current manual of survey instructions of the United States Department of the Interior, Bureau of Land Management or by a decree of a Court of Law and/or that the corner points mentioned in lines 3, 4 and 5 above were in conformance with the rules of the Michigan Board of Land Surveyors or by a Decree of a Court of Law; established, re-established, monumented, re-monumented, recovered, found as expressed below:

NOTE: Not more than 4 corners, all in the same town and range, may be recorded on this certificate.

A. Description of original monument and accessories and/or subsequent restoration:

History: 1821 West line run by Joseph Wampler. 1834 Subdivision of township by Hiram Burnham. Corner not set. County Surveyor Record: Book 2 1866 & 1873 stake jog 161 L (106.26) Pine 24, S83 1/2W 96, Pine 24 S47E 84 1/2. A-6 to A-7 39.86 (2630.76) A-6 to A-5 same. Act 74 none. Road Commission Nothing.

B. Description of corner evidence found and/or method applied in restoring or reestablishing corner:


Site Conditions: Rolling Farmland, Summers Road gravel North-South, no occupation to East, set 1/2" iron by proration, A-6 to A-7 2631.14, A-6 to A-5 2631.14, M-6 to A-6 North 109.85.

PEER GROUP
APPROVED LAND CORNER
PA 345 OF 1990
LAPEER COUNTY

RAY DAVIS P.S. CO. SURVEYOR
DATE 9-17-98

C. Description of monument for corner and accessories established to perpetuate locating the position of the corner:

NOVEMBER 9, 1998
FOUND 1/2" RE-ROD IN PLACE, SET BRASS CAP
S24°W 68.76' NAIL & TAG EAST SIDE 8" ASH
S66°W 29.65' NAIL & TAG NORTH SIDE 22" MAPLE
N14°W 118.46' NAIL & TAG EAST SIDE 24" MAPLE
N12°E 118.47' NAIL & TAG WEST SIDE 22" MAPLE
SOUTH 109.85' M-6

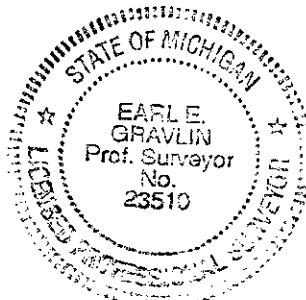

Signed by [Signature] Surveyor's Michigan License No. 23510

Date 11-16-98