

MAR 29 1999

REMONUMENTATION

SECTION

LAND CORNER RECORDATION CERTIFICATE
Filing Requirement of Act 74, Mich. P.A. 1970

RECEIVED FOR RECORD
98 NOV 25 AM 9: 25

For corners in
LAPEER

(County)

Located In: BURNSIDE SOUTH Corner Code # A-7

- 1. Public Land Survey T 9N R 12E A-7
- T _____ R _____
- T _____ R _____
- T _____ R _____
- 2. Property Controlling S _____ T _____ R _____
- in Section S _____ T _____ R _____
- 3. Miscellaneous S _____ T _____ R _____
- Property in Sec. S _____ T _____ R _____

Melissa DeVaugh
REGISTER OF DEEDS
LAPEER COUNTY, MICHIGAN

410

Register of Deeds Stamp & File Number

	A	B	C	D	E	F	G	H	I	J	K	L	M
2	6	5	4	3	2	1							
3													
4	7	8	9	10	11	12							
5													
6	18	17	16	15	14	13							
7													
8	19	20	21	22	23	24							
9													
10	30	29	28	27	26	25							
11													
12	31	32	33	34	35	36							
13													

- 4. Lot No. _____, Recorded Plat _____
- 5. Private Claims _____

Earl E. Gravlin in a field survey on July 15, 19 98

do hereby certify that under requirements of P.A. 74, Michigan P.A. of 1970, the corner points mentioned in lines 1 and 2 above were in conformance with regulations and rules therefore as required in the current manual of survey instructions of the United States Department of the Interior, Bureau of Land Management or by a decree of a Court of Law and/or that the corner points mentioned in lines 3, 4 and 5 above were in conformance with the rules of the Michigan Board of Land Surveyors or by a Decree of a Court of Law; established, re-established, monumented, re-monumented, recovered, found as expressed below:

NOTE: Not more than 4 corners, all in the same town and range, may be recorded on this certificate.

A. Description of original monument and accessories and/or subsequent restoration:

History: 1821 West line run by Joseph Wampler. 1834 Subdivision of township by Hiram Burnham. Intersect Range Line 164 L(108.24) North Set Post Cor to 18 & 19 Beech 7 In S25E 49 do 6 In N77E 28. County Surveyor Record: Book 2 1866 & 1873 stake, Pine 40, S55 1/2E 57, Pine 40 S64 1/2E 67. A-7 to A-6 39.86 (2630.76). Act 74 none. Road Commission Nothing.

3. Description of corner evidence found and/or method applied in restoring or reestablishing corner:


Site Conditions: Rolling Farmland, Gravel Road North-South, Gravel Road to East, Set 1/2" iron 164 links (108.24) North of M-7, A-7 to A-8 2640.64, A-7 to A-6 2631.14, M-7 to A-7 North 108.24.

PEER GROUP
APPROVED LAND CORNER
PA 245 OF 1990
LAPEER COUNTY

Ray Davis
RAY DAVIS P.S. CO. SURVEYOR
DATE 09-17-98

C. Description of monument for corner and accessories established to perpetuate locating the position of the corner:

NOVEMBER 9, 1998
FOUND 1/2" RE-ROD IN PLACE, SET BRASS CAP
N59°W 36.95' NAIL & TAG NORTH SIDE 36" MAPLE
N37°E 55.07' NAIL & TAG WEST SIDE 15" MAPLE
N13°W 120.69' NAIL & TAG EAST SIDE 30" OAK
S23°W 79.26' NAIL & TAG EAST SIDE 30" MAPLE
S24°E 83.30' NAIL & TAG EAST SIDE 13" POPLAR
SOUTH 108.24' M-7

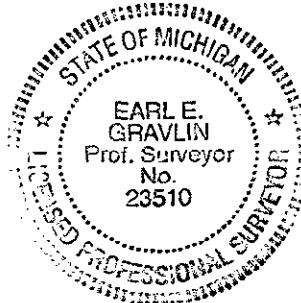

Signed by *Earl E. Gravlin* Date 11-16-98
Surveyor's Michigan License No. 23510