

MAR 29 1999

REMONUMENTATION

LAND CORNER RECORDATION CERTIFICATE
Filing Requirement of Act 74, Mich. P.A. 1970

RECEIVED FOR RECORD

98 NOV 25 AM 9:26

For corners in
LAPEER

SECTION

Located in: Corner Code #

1. Public Land Survey Located in: BURNSIDE SOUTH Corner Code # A-8
 T 9N R 12E
 T _____ R _____
 T _____ R _____
 T _____ R _____
2. Property Controlling in Section S _____ T _____ R _____
 S _____ T _____ R _____
3. Miscellaneous Property in Sec. S _____ T _____ R _____
 S _____ T _____ R _____
4. Lot No. _____, Recorded Plat _____
5. Private Claims _____

Melissa De Vaughn
REGISTER OF DEEDS
LAPEER COUNTY, MICHIGAN

411

Register of Deeds Stamp & File Number

A	B	C	D	E	F	G	H	I	J	K	L	M

Earl E. Gravlin, in a field survey on July 15, 1998, hereby certify that under requirements of P.A. 74, Michigan P.A. of 1970, the corner points mentioned in lines 1 and 2 above were in conformance with regulations and rules therefore as required in the current manual of survey instructions of the United States Department of the Interior, Bureau of Land Management or by a decree of a Court of Law and/or that the corner points mentioned in lines 3, 4 and 5 above were in conformance with the rules of the Michigan Board of Land Surveyors or by a Decree of a Court of Law; established, re-established, monumented, re-monumented, recovered, found as expressed below:

NOTE: Not more than 4 corners, all in the same town and range, may be recorded on this certificate.

A. Description of original monument and accessories and/or subsequent restoration:
History: 1821 West line run by Joseph Wampler. 1834 Subdivision of township by Hiram Burnham. Corner not set. County Surveyor Record none. Act 74 none. Recorded surveys, Gravlin L0011 P 0637, Fd re-rod N45E 42.50 SE cor cor tele ped, N85W 19.82 S leg of sign, S30E 65.83 re-mon tag NW side 8" basswood. Road Commission Nothing. Gravlin A-8 to A-9 2653.03

B. Description of corner evidence found and/or method applied in restoring or reestablishing corner:


Site Conditions: Rolling Farmland, Summers Road gravel North-South, Linck Road gravel East, found 1/2" iron. A-8 to A-9 2653.03, A-8 to A-7 2640.64, M-8 to A-8 North 89.65

PEER GROUP
APPROVED LAND CORNER
PA 345 OF 1990
LAPEER COUNTY

RAY DAVIS P.S. CO. SURVEYOR
DATE 9-17-98

C. Description of monument for corner and accessories established to perpetuate locating the position of the corner:

NOVEMBER 9, 1998
FOUND 1/2" RE-ROD IN PLACE, SET BRASS CAP
N23°E 65.36' NAIL & TAG WEST SIDE 6" POPLAR
S08°W 127.10' NAIL & TAG EAST SIDE 18" ELM
N20°E 87.90' NAIL & TAG WEST SIDE 16" OAK
S84°E 130.31' NAIL & TAG NORTH SIDE 14" OAK
SOUTH 89.65' M-8

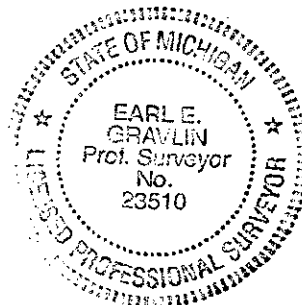

Signed by [Signature] Date 11-16-98

Surveyor's Michigan License No. 23510