

MAR 29 1999

REMONUMENTATION

SECTION

LAND CORNER RECORDATION CERTIFICATE
Filing Requirement of Act 74, Mich. P.A. 1970

RECEIVED FOR RECORD

98 NOV 25 AM 9:29

For corners in
LAPEER

(County)

Located In:

Corner Code #

Burnside South

- 1. Public Land Survey T 9N R 12E A-11
T _____ R _____
T _____ R _____
T _____ R _____
- 2. Property Controlling S _____ T _____ R _____
in Section S _____ T _____ R _____
- 3. Miscellaneous S _____ T _____ R _____
Property in Sec. S _____ T _____ R _____
- 4. Lot No. _____, Recorded Plat _____
- 5. Private Claims _____

Malissa DeVaugh
REGISTER OF DEEDS
LAPEER COUNTY, MICHIGAN

714

Register of Deeds Stamp & File Number

A	B	C	D	E	F	G	H	I	J	K	L	M
2	6	5	4	3	2	1						
3												
4	7	8	9	10	11	12						
5												
6	18	17	16	15	14	13						
7												
8	19	20	21	22	23	24						
9												
10	30	29	28	27	26	25						
11												
12	31	32	33	34	35	36						
13												

I, Earl E. Gravlin, in a field survey on July 15, 19 98, do hereby certify that under requirements of P.A. 74, Michigan P.A. of 1970, the corner points mentioned in lines 1 and 2 above were in conformance with regulations and rules therefore as required in the current manual of survey instructions of the United States Department of the Interior, Bureau of Land Management or by a decree of a Court of Law and/or that the corner points mentioned in lines 3, 4 and 5 above were in conformance with the rules of the Michigan Board of Land Surveyors or by a Decree of a Court of Law; established, re-established, monumented, re-monumented, recovered, found as expressed below:

NOTE: Not more than 4 corners, all in the same town and range, may be recorded on this certificate.

A. Description of original monument and accessories and/or subsequent restoration:
History: 1821 West line run by Joseph Wampler. 1834 Subdivision of township by Hiram Burnham. Intersect Range Line 41 L (27.06) North, Set Post Cor to 30 & 31 B.Ash 6 In S53E 10 L, B.Ash 8 In N40E 22. County Surveyor Record: Book 2 1866 stake(Cedar) Pine 28, N49W 60, Pine 30 S36W 109 1/2. Act 74 Gravlin L004 P141, Set Iron, N45E 48.90 cor post, S45W 65.90 stop sign, S20W 78.90 12" culvert end. Recorded survey, Gravlin, L007 P823, same. Unrecorded surveys Gravlin, Date 6-26-1998, Job No 980114, witnesses same as L007 P823. Road Commission Nothing. Gravlin A-11 to A-10 2642.46.

B. Description of corner evidence found and/or method applied in restoring or reestablishing corner:


Site Conditions: Rolling Farmland, Found 1/2" iron Summers Road gravel North-South, Willis Road gravel East-West, A-11 to A-12 2648.00, A-11 to A-10 2642.46, M-11 to A-11 North 26.59

PEER GROUP
APPROVED LAND CORNER
PA 345 OF 1990
LAPEER COUNTY

Ray Davis
RAY DAVIS P.S. CO. SURVEYOR
DATE 9-17-98

C. Description of monument for corner and accessories established to perpetuate locating the position of the corner:

NOVEMBER 9, 1998
FOUND 1/2" RE-ROD IN PLACE, SET BRASS CAP
N27°E 115.14' NAIL & TAG WEST SIDE POWER POLE
S58°W 102.50' NAIL & TAG NORTH SIDE CORNER POST
S23°E 70.20' NAIL & TAG WEST SIDE 6" CHERRY
S13°E 138.16' NAIL & TAG WEST SIDE 20" STUMP
SOUTH 26.59' M-11

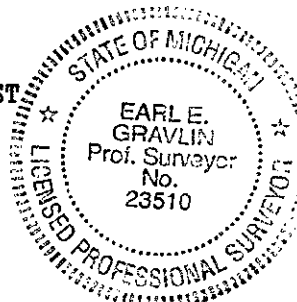

Signed by *Earl E. Gravlin*
Surveyor's Michigan License No. 23510

Date 11-16-98