

MAR 29 1999

REMONUMENTATION

SECTION

LAND CORNER RECORDATION CERTIFICATE
Filing Requirement of Act 74, Mich. P.A. 1970

RECEIVED FOR RECORD

98 NOV 25 AM 9:30

For corners in
LAPEER
(County)

Located In: Burnside South Corner Code A-12

- 1. Public Land Survey T 9N R 12E A-12
- 2. Property Controlling in-Section S _____ T _____ R _____
- 3. Miscellaneous Property in Sec. S _____ T _____ R _____
- 4. Lot No. _____, Recorded Plat _____
- 5. Private Claims _____

Makisa De Vaughn
REGISTER OF DEEDS
LAPEER COUNTY MICHIGAN

415
Register of Deeds Stamp & File Number

	A	B	C	D	E	F	G	H	I	J	K	L	M
2													
3													
4	7	8	9	10	11	12							
5													
6	18	17	16	15	14	13							
7													
8	19	20	21	22	23	24							
9													
10	30	29	28	27	26	25							
11													
12	31	32	33	34	35	36							
13													

1. Earl E. Gravlin in a field survey on July 15, 19 98, do hereby certify that under requirements of P.A. 74, Michigan P.A. of 1970, the corner points mentioned in lines 1 and 2 above were in conformance with regulations and rules therefore as required in the current manual of survey instructions of the United States Department of the Interior, Bureau of Land Management or by a decree of a Court of Law and/or that the corner points mentioned in lines 3, 4 and 5 above were in conformance with the rules of the Michigan Board of Land Surveyors or by a Decree of a Court of Law; established, re-established, monumented, re-monumented, recovered, found as expressed below:

NOTE: Not more than 4 corners, all in the same town and range, may be recorded on this certificate.

A. Description of original monument and accessories and/or subsequent restoration:
History: 1821 West line run by Joseph Wampler. 1834 Subdivision of township by Hiram Burnham. Corner not set. County Surveyor Record: Book 2 1866 stake White Oak 30, N25W 93, Pine 40 S18W 117 1/2. Act 74 Gravlin L004 P141. Recorded survey, Gravlin, L007 P823, Found 1/2" Iron, N62E 71.65 15" Elder, N80E 25.80 18" Elder, S50E 51.81 6" Elder. Road Commission Nothing. Gravlin A-12 to A-11 2647.71,

B. Description of corner evidence found and/or method applied in restoring or reestablishing corner:


Site Conditions: Rolling Farmland Found 1/2" iron Summers Road gravel North-South, Fence line to East, A-12 to A-13 2636.55, A-12 to A-11 2648.00, A-12 to M-12 7.57

PEER GROUP
APPROVED LAND CORNER
PA 345 OF 1990
LAPEER COUNTY

Ray Davis
RAY DAVIS P.S. CO. SURVEYOR
DATE 9-17-98

C. Description of monument for corner and accessories established to perpetuate locating the position of the corner:

NOVEMBER 9, 1998
FOUND 1/2" RE-ROD IN PLACE, SET BRASS CAP
N19°E 71.99' NAIL & TAG WEST SIDE 24" MAPLE
N57°W 71.57' NAIL & TAG SOUTH SIDE POWER POLE
N63°E 25.98' NAIL & TAG NORTH SIDE 12" BOX ELDER
S30°E 51.21' EAST SIDE 8" BOX ELDER
SOUTH 7.57' M-12

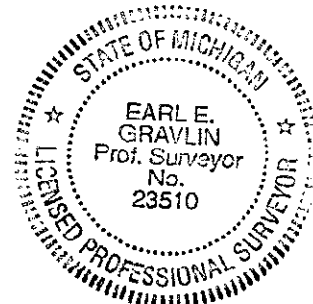

Signed by *Earl E. Gravlin*

Date 11-16-98

Surveyor's Michigan License No. 23510