

SURVEY &
REMONUMENTATION

1993

COMMISSION

REMONUMENTATION
LAND CORNER RECORDATION CERTIFICATE
Filing Requirement of Act 74, Mich. P.A. 1970

RECEIVED FOR RECORD

93 DEC 22 PM 2:07

LIBER 5
36
Mills
Mills
RECORDS SECTION
LAPEER

For corners in

LAPEER

(County)

Located In:

Corner Code ##

- | | | | | | |
|------------------------------------|---|----|---|-----|------|
| 1. Public Land Survey | T | 9N | R | 12E | M-13 |
| | T | | R | | |
| | T | | R | | |
| | T | | R | | |
| 2. Property Controlling in Section | S | | T | R | |
| | S | | T | R | |
| 3. Miscellaneous Property in Sec. | S | | T | R | |
| | S | | T | R | |
4. Lot No. _____, Recorded Plat _____
5. Private Claims _____

Register of Deeds Stamp & File Number

I, Earl E. Gravlin, in a field survey on October, 19 93, do hereby certify that under requirements of P.A. 74, Michigan P.A. of 1970, the corner points mentioned in lines 1 and 2 above were in conformance with regulations and rules therofore as required in the current manual of survey instructions of the United States Department of the Interior, Bureau of Land Management or by a decree of a Court of Law and/or that the corner points mentioned in lines 3, 4 and 5 above were in conformance with the rules of the Michigan Board of Land Surveyors or by a Decree of a Court of Law; established, re-established, monumented, re-monumented, recovered, found as expressed below:

NOTE: Not more than 4 corners, all in the same town and range, may be recorded on this certificate.

A. Description of original monument and accessories and/or subsequent restoration:


M-13. Southeast corner Section 36
East and South town lines run by Joseph Wampler, 1821. Pages 630 and 631.
Subdivision of township run by Hiram Burnham, second quarter, 1834. page 638-640. Witnesses Beech 9 S58°W .6 Ironwood 9 N E .16 set post. County Surveyors Record: Book 2, page 96, Southwest quarter only Recorded surveys L5 P464 Gravlin L9 P952-53 Gravlin. Act 74 L4 P 276 Gravlin. Unrecorded surveys Kay 3/31/72 1/8/12, Kay 2/15/73 1/8/12.

B. Description of corner evidence found and/or method applied in restoring or reestablishing corner:

Site conditions: Flat farmland intersections Cade Road(gravel) and Clear Lake Road(gravel) fence to east. Found "T" iron in place. Also "T" iron 1.8' east and "T" iron 10' north. Iron found appeared oldest and had been used in recent surveys. Occupation fence row to east, centerline road to west.
MEASUREMENT M-13 TO M-12 2640.43

C. Description of monument for corner and accessories established to perpetuate locating the position of the corner:

October 19, 1993
Found "T" iron in place. Replaced with 18" iron and brass cap
N40°W 56.19' NAIL & TAG E SIDE GTE POLE
S45°E 73.67' NAIL & TAG NE SIDE POWER POLE
N07°W 224.96' NAIL & TAG E SIDE 24" MAPLE
N78°W 123.53' FACE SIGN POST

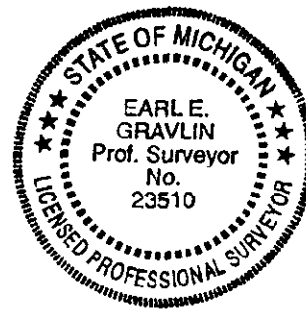

Signed by

[Signature]

Date

12/02/93

Surveyor's Michigan License No.

23510