

MAR 29 1999

1998 REMONUMENTATION PROGRAM  
LAND CORNER RECORDATION CERTIFICATE  
Filing Requirement of Act 74, Mich. P.A. 1970

RECEIVED FOR RECORD  
98 DEC 22 PM 3:40

For corners in: RICH TWP.

<u>LAPEER</u> (County)	Located In:	Corner Code #
1. Public Land Survey	T <u>10N</u> R <u>10E</u>	<u>C-13</u>
	T _____ R _____	_____
	T _____ R _____	_____
	T _____ R _____	_____
2. Property Controlling in Section	S _____ T _____ R _____	_____
	S _____ T _____ R _____	_____
3. Miscellaneous Property in Sec.	S _____ T _____ R _____	_____
	S _____ T _____ R _____	_____
4. Lot No. _____	Recorded Plat _____	
5. Private Claims _____		

Melissa De Vlieg  
REGISTERED CLERK OF DEEDS  
LAPEER COUNTY, MICHIGAN

421

Register of Deeds Stamp & File Number

	A	B	C	D	E	F	G	H	I	J	K	L	M
1													
2	6	5	4	3	2	1							
3													
4	7	8	9	10	11	12							
5													
6	18	17	16	15	14	13							
7													
8	19	20	21	22	23	24							
9													
10	30	29	28	27	26	25							
11													
12	31	32	33	34	35	36							
13													

I, JONATHAN M. FIELD, in a field survey on JUNE 30 1998, do hereby certify that under requirements of P.A. 74, Michigan P.A. of 1970, the corner points mentioned in lines 1 and 2 above were in conformance with regulations and rules therefore as required in the current manual of survey instructions of the United States Department of the Interior, Bureau of Land Management or by a decree of a Court of Law and/or that the corner points mentioned in lines 3, 4 and 5 above were in conformance with the rules of the Michigan Board of Land Surveyors or by a Decree of a Court of Law; established, re-established, monumented, re-monumented, recovered, found as expressed below:

NOTE: Not more than 4 corners, all in the same town and range, may be recorded on this certificate.

A. Description of original monument and accessories and/or subsequent restoration:  
 1833 GLO; PARKE, D.S.; SET POST; BEECH 12 N35E 18 LKS, BEECH 10 N64E 11 LKS.  
 1906 SICKLESTEEL, C.S.; SURVEY SEC. 32, T10N-R10E; PG. 106-107; STAKE; PINE STUMP 30 S26W 72 LKS.  
 1989 GRAVLIN, P.S.#23510; SURVEY L.008, PG.371; SET. 1/2" IRON; N55°W 47.56' COR POST, N45°E 42.72' 15" ELM, S75°E 110.55' WOOD POST  
 1991 GRAVLIN, P.S.#23510; SURVEY L.009, PG.389-90; FND. 1/2" IRON; SAME WITS AS 1989 SURVEY ABOVE  
 1993 GRAVLIN, P.S.#23510; SURVEY L.010, PG.242; FND. 1/2" IRON; SAME WITS AS 1989 SURVEY ABOVE

B. Description of corner evidence found and/or method applied in restoring or reestablishing corner:  
 1998 ROWE; FIELD, PS#37276; FND. 1/2" ROD W/ CAP 2' N. OF C/L CASTLE ROAD & 4' W. OF C/L RICH ROAD  
 RECOVERED 3 PREVIOUS WITNESSES WHICH INDICATE THAT FND. ROD IS IN SAME POSITION AS 1989 IRON CITED IN SECTION A ABOVE

C-13 TO B-13 2640' (G.L.O.)                      C-13 TO D-13 2640' (G.L.O.)  
 2674.30' (GRAVLIN '89, '91)                      2649.04' (GRAVLIN '93)  
 2674.24' (ROWE '98)                                      2649.11' (ROWE '98)


C-13 TO C-1 176.88' (G.L.O.)  
 157.04' (ROWE '98)

ACCEPTED FND. ROD AS A CAREFUL AND FAITHFUL PERPETUATION OF THE ORIGINAL CORNER POSITION

C. Description of monument for corner and accessories established to perpetuate locating the position of the corner:

C-13 SET STD. REMON CAP ON FND. 1/2" ROD  
 EAST, 157.04' FND. 1/2" ROD  
 N60°W, 47.53' NAIL IN S. FACE FENCE POST  
 N53°E, 42.73' NAIL IN S. FACE 18" BEECH  
 S72°E, 110.43' NAIL IN N. FACE FENCE POST  
 N24°E, 79.56' NAIL IN NW FACE 15" PINE

APPROVED BY SURVEYOR

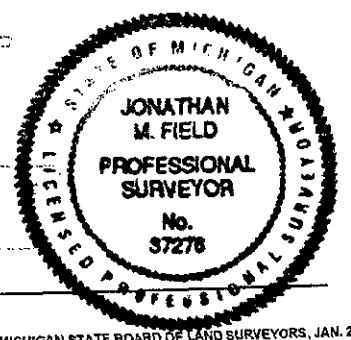

Signed by Jonathan M. Field

Date 9-17-98  
10-28-98

Surveyor's Michigan License No. 37276

FORM APPROVED BY MICHIGAN STATE BOARD OF LAND SURVEYORS, JAN. 28, 1971  
 REVISED MAY 14, 1975  
 REVISED JAN., 1983  
 ADAPTED FOR WORD PROCESSING MARCH, 1993