

SURVEY &
REMONUMENTATION

MAY 28 1997

COMMISSIONER

1996 REMONUMENTATION PROGRAM
LAND CORNER RECORDATION CERTIFICATE

Filing Requirement of Act 74, Mich. P.A. 1970

RECEIVED RECORD

96 DEC 27 PM 1:15

For corners in RICH TWP.

<u>LAPPEER</u> (County)	Located In:	Corner Code #
1. Public Land Survey	T <u>10N</u> R <u>10E</u>	<u>G-13</u>
	T _____ R _____	_____
	T _____ R _____	_____
	T _____ R _____	_____
2. Property Controlling in Section	S _____ T _____ R _____	_____
	S _____ T _____ R _____	_____
3. Miscellaneous Property in Sec.	S _____ T _____ R _____	_____
	S _____ T _____ R _____	_____
4. Lot No. _____, Recorded Plat _____		
5. Private Claims _____		

William DeVaugh
REGISTER OF DEEDS
LAPPEER COUNTY MICHIGAN

Register of Deeds Stamp & File Number

I, JONATHAN M. FIELD, in a field survey on AUGUST 19 96,

do hereby certify that under requirements of P.A. 74, Michigan P.A. of 1970, the corner points mentioned in lines 1 and 2 above were in conformance with regulations and rules therefore as required in the current manual of survey instructions of the United States Department of the Interior, Bureau of Land Management or by a decree of a Court of Law and/or that the corner points mentioned in lines 3, 4 and 5 above were in conformance with the rules of the Michigan Board of Land Surveyors or by a Decree of a Court of Law; established, re-established, monumented, re-monumented, recovered, found as expressed below:

NOTE: Not more than 4 corners, all in the same town and range, may be recorded on this certificate.

	A	B	C	D	E	F	G	H	I	J	K	L	M
1													
2	6	5	4	3	2	1							
3													
4	7	8	9	10	11	12							
5													
6	18	17	16	15	14	13							
7													
8	19	20	21	22	23	24							
9													
10	30	29	28	27	26	25							
11													
12	31	32	33	34	35	36							
13													

A. Description of original monument and accessories and/or subsequent restoration:

1833 GLO; PARKE, D.S.; SET POST; W. ASH 12 N67E 43LKS., ELM 10 N33W 9LKS.
1978 BECK, P.S.#21559; SURVEY L.005, PG.104; FND NAIL IN PAVEMENT; N50E 53.62' NAIL W/DISC IN 6" MAPLE, S45W 28.42' E. EDGE OF E. LEG RD. SIGN; N60W 49.31' E. EDGE STOP SIGN

GLO NOTES OF T9N-R10E INDICATE THAT THIS CORNER IS NOT COMMON WITH G-1 T9N-R10E

B. Description of corner evidence found and/or method applied in restoring or reestablishing corner:

18'E. OF C/L
1996 ROWE ENG.; FIELD, P.S.#37276; FND 1/2" ROD AT C/L CASTLE RD. E-W & ON C/L EXTENDED OF BECK RD. TO N. RECOVERED 2 PREVIOUS WITNESSES INDICATING THAT FND ROD IS IN THE SAME POSITION AS 1978 NAIL CITED ABOVE

G-13 TO F-13 2653.51'
G-13 TO H-13 2647.90'
G-13 TO G-12 2651.08' (2651.09' BECK 1978)

ACCEPTED FND 1/2" ROD AS BEST EVIDENCE OF ORIGINAL CORNER POSITION


PEER GROUP
APPROVED LAND CORNER
PA 345 OF 1990
LAPPEER COUNTY

Ray Davis
RAY DAVIS P.S. CO. SURVEYOR

DATE 8-27-96

C. Description of monument for corner and accessories established to perpetuate locating the position of the corner:

G-13 SET STANDARD REMON CAP ON FND 1/2" ROD
N50°W, 94.51' P-K NAIL IN NE FACE TWIN 12" ELM
N55°E, 53.95' P-K NAIL IN SE FACE 8" CLUMP MAPLE
S55°E, 69.08' P-K NAIL IN N FACE 6" TWIN OAKS
S40°W, 29.40' P-K NAIL IN NW FACE 6" OAK
EAST, 148.57' FND. 1/2" ROD

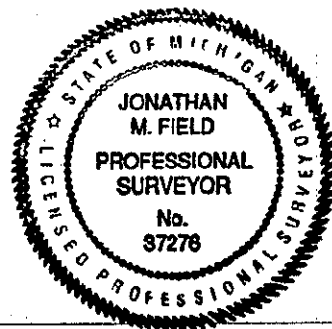

Signed by Jonathan M. Field Date 12-2-96
Surveyor's Michigan License No. 37276

FORM APPROVED BY MICHIGAN STATE BOARD OF LAND SURVEYORS, JAN. 28, 1971
REVISED MAY 14, 1975
REVISED JAN., 1983
ADAPTED FOR WORD PROCESSING MARCH, 1993