

**SURVEY & REMONUMENTATION**

APR 28 1995

COMMISSION

**1994 REMONUMENTATION PROGRAM  
LAND CORNER RECORDATION CERTIFICATE**  
Filing Requirement of Act 74, Mich. P.A. 1970

RECEIVED FOR RECORD

94 DEC 22 PM 2: 10

LIBER NO. 05 PAGE NO. 186  
*Melissa De Vaux*  
REGISTER OF DEEDS  
LAPPEER COUNTY, MICHIGAN

For corners in RICH TWP. LAPPEER (County)	Located In:	Corner Code #
1. Public Land Survey	T 10N R 10E	L-13
	T _____ R _____	_____
	T _____ R _____	_____
	T _____ R _____	_____
2. Property Controlling in Section	S _____ T _____ R _____	_____
	S _____ T _____ R _____	_____
3. Miscellaneous Property in Sec.	S _____ T _____ R _____	_____
	S _____ T _____ R _____	_____
4. Lot No. _____	Recorded Plat _____	
5. Private Claims _____		

Register of Deeds Stamp & File Number

	A	B	C	D	E	F	G	H	I	J	K	L	M
1													
2	6	5	4	3	2	1							
3													
4	7	8	9	10	11	12							
5													
6	18	17	16	15	14	13							
7													
8	19	20	21	22	23	24							
9													
10	30	29	28	27	26	25							
11													
12	31	32	33	34	35	36							
13													

I, JONATHAN M. FIELD, in a field survey on SEPTEMBER 23 19 94 do hereby certify that under requirements of P.A. 74, Michigan P.A. of 1970, the corner points mentioned in lines 1 and 2 above were in conformance with regulations and rules therefore as required in the current manual of survey instructions of the United States Department of the Interior, Bureau of Land Management or by a decree of a Court of Law and/or that the corner points mentioned in lines 3, 4 and 5 above were in conformance with the rules of the Michigan Board of Land Surveyors or by a Decree of a Court of Law; established, re-established, monumented, re-monumented, recovered, found as expressed below:

NOTE: Not more than 4 corners, all in the same town and range, may be recorded on this certificate.

- A. Description of original monument and accessories and/or subsequent restoration:
- 1834 GLO; PARKE, D.S.; SET 1/4 POST; BEECH 11 N69E 50LKS., BEECH 13 N36W 80LKS.
  - 1906 SICKLESTEEL, C.S.; STONE 25X12X8 SMALL STONES; PINE 34 S70E 100LKS., PINE 30 N71E 108LKS
  - 1971 HENDERSON-RATES; HENDERSON, P.S.#16043; SURVEY L.1, PG.608; SET 1/2" RE-ROD; S45°E 42.45' 9" POPLAR, S5°E 35.61' 12" CHERRY CLUSTER, N30°W 29.02' 10" CHERRY
  - 1972 HENDERSON, P.S.#16043; LCRC L.1, PG.531; SET 1/2" ROD (NO METHOD GIVEN); SAME WITS AS 1971 SURVEY ABOVE
  - 1982 CORNERSTONE; WIZYNAJTYS, P.S.#21585; SURVEY L.6, PG.478; FND 1/2" ROD; NO WITS GIVEN
  - 1989 GRAVLIN, P.S.#23510; SURVEY L.8, PG.202; FND 1/2" ROD; WITS SAME AS 1971 SURVEY ABOVE
  - 1991 NORTHEAST SURVEY; BAILEY, P.S.#33968; SURVEY L.9, PG.354; FND 1/2" ROD; E. 4.6' N1/4 COR N. 32.52' FND IRON #21585, S5°W 19.22' 8" POPLAR, N10°W 29.7' 24" CHERRY


- B. Description of corner evidence found and/or method applied in restoring or reestablishing corner:
- 1994 ROWE ENG.; FIELD, P.S.#37276; FND BENT 1/2" ROD 1.5' S. OF C/L GRAVEL ROAD E-W & ON TREE LINE TO N. RECOVERED 1 PREVIOUS WITNESS INDICATING THAT FND ROD IS IN SAME POSITION AS 1971 HENDERSON-RATES SURVEY

2632.41' L-13 TO K-13 (MEAS. BY OTHERS)

ACCEPTED 1/2" ROD AS A CAREFUL AND FAITHFUL PERPETUATION OF THE ORIGINAL CORNER POSITION

- C. Description of monument for corner and accessories established to perpetuate locating the position of the corner:
- L-13 REMOVED BENT ROD, SET 1/2" X 18" ROD W/ STANDARD BRASS CAP
  - EAST, 4.66' FND 1/2" ROD
  - N30°W, 29.68' SET NAIL W/REMON TAG ABOVE FND P-K NAIL W/FLAG. IN SW FACE 16" CHERRY
  - NORTH, 32.45' FND 1/2" ROD W/CAP #21585
  - S10°W, 19.17' SET NAIL W/REMON TAG ABOVE FND NAIL W/FLAG. IN SE FACE 8" POPLAR
  - S08°E, 33.01' FND 1/2" ROD W/CAP #23510
  - SOUTH, 29.37' FND NAIL W/FLAG. IN E. FACE 10" CHERRY
  - S40°E, 35.28' SET NAIL W/REMON TAG ABOVE FND P-K NAIL W/FLAG. IN NE FACE 16" BOXELDER

PEER GROUP  
APPROVED LAND CORNER  
Signed by J.M. Field Date 12-8-94  
Surveyor License No: 37276

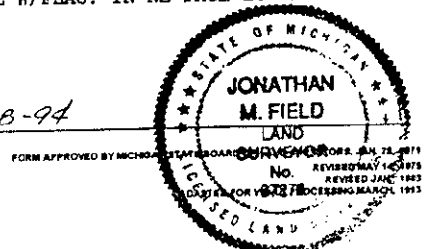

RAY DAVIS P.S. CO. SURVEYOR  
DATE 12-22-94

LIBER 005 PAGE 186