

SURVEY & REMONUMENTATION

APR 29 1995

COMMISSION

LAND CORNER RECORDATION CERTIFICATE RECEIVED FOR RECORD

Filing Requirement of Act 74, Mich. P.A. 1970 95 DEC 13 AM 8:59
1995 REMONUMENTATION PROGRAM

For corners in RICH TWP.
LAPEER
(County)

Located In: Corner Code #

LIBER NO. 5 PAGE NO. 319
Melissa DeVaugh
REGISTER OF DEEDS
LAPEER COUNTY MICHIGAN

1. Public Land Survey	T	10N	R	10E	M-7
	T		R		
	T		R		
	T		R		
2. Property Controlling in Section	S	T	R		
	S	T	R		
3. Miscellaneous Property in Sec.	S	T	R		
	S	T	R		

Register of Deeds Stamp & File Number

4. Lot No. _____, Recorded Plat _____
5. Private Claims _____

I, JONATHAN M. FIELD, in a field survey on MARCH 19 95, do hereby certify that under requirements of P.A. 74, Michigan P.A. of 1970, the corner points mentioned in lines 1 and 2 above were in conformance with regulations and rules therefore as required in the current manual of survey instructions of the United States Department of the Interior, Bureau of Land Management or by a decree of a Court of Law and/or that the corner points mentioned in lines 3, 4 and 5 above were in conformance with the rules of the Michigan Board of Land Surveyors or by a Decree of a Court of Law; established, re-established, monumented, re-monumented, recovered, found as expressed below:

	A	B	C	D	E	F	G	H	I	J	K	L	M
1													
2	6	5	4	3	2	1							
3													
4	7	8	9	10	11	12							
5													
6	18	17	16	15	14	13							
7													
8	19	20	21	22	23	24							
9													
10	30	29	28	27	26	25							
11													
12	31	32	33	34	35	36							
13													

NOTE: Not more than 4 corners, all in the same town and range, may be recorded on this certificate.

- A. Description of original monument and accessories and/or subsequent restoration:
- 1833 GLO; PARKE, D.S.; SET POST; SUGAR 16 S45W 38LKS., BEECH 5 N43W 8LKS.
 - 1974 COMMONWEALTH; SWARTS, P.S.#16945; SURVEY L.2, PG.942; SET 1/2" IRON; N10W 37.60' FE POST S10W 23.72' FE POST, S45E 29.30' FE POST
 - 1974 COMMONWEALTH; SWARTS, P.S.#16945; SURVEY L.2, PG.944; SET 1/2" RE-BAR; SAME WITS AS SURVEY ABOVE
 - 1974 SWARTS, P.S.#16945; LCRC L.2, PG.633; SET 1/2" IRON BY SINGLE PROPORTIONATE MEASUREMENT; SAME WITS AS SURVEY ABOVE
 - 1986 GRAVLIN, P.S.#23510; SURVEY L.7, PG.446; SET 1/2" IRON; SOUTH 31.80' P.POLE, S45W 33.55' W. END 12" CMP, N10W 27.75' FACE OF PHONE BOX

- B. Description of corner evidence found and/or method applied in restoring or reestablishing corner:
- 1995 ROWE ENG.; FIELD, P.S.#37276; FND 1/2" ROD ON C/L GRAVEL ROAD E-W, 2'E. OF FENCE LINE TO N., OVERHEAD POWER LINES TO S. ALSO FND FE POSTS NW & SW AT DIST'S GIVEN BY SWARTS IN 1974 BUT POSTS ARE LEANING. ALSO FND W. END OF CMP GIVEN BY GRAVLIN IN 1986 AT APPROX. DIST. BUT IS NOW BURIED

G.L.O. NOTES FOR T9N-R11E INDICATE THAT THIS CORNER IS COMMON WITH A-7 T10N-R11E


M-7 TO M-8 2647.43' (GRAVLIN 1986) M-7 TO M-9 5304.51 (GRAVLIN)
M-7 TO M-6 2658.22' (SWARTS 1974) M-7 TO M-9 5304.44 (REI 1995)

ACCEPTED FND ROD AS A CAREFUL AND FAITHFUL PERPETUATION OF THE ORIGINAL CORNER POSITION

- C. Description of monument for corner and accessories established to perpetuate locating the position of the corner:

M-7 SET STANDARD BRASS CAP ON FND 1/2" ROD
S05°W, 31.35' SET NAIL W/REMON TAG IN E. FACE T. POLE
N10°W, 28.50' TOP CENTER OF PHONE RISER
N55°E, 23.09' SET 1/2" ROD W/CAP #37276
N60°W, 22.90' SET 1/2" ROD W/CAP #37276
SOUTH, 32.62' FND 1/2" ROD W/CAP #23510

PEER GROUP
APPROVED LAND CORNER
PA 345 OF 1090
LAPEER COUNTY
[Signature]
RAY CAWS P.S. CO. SURVEYOR
DATE 7-13-95

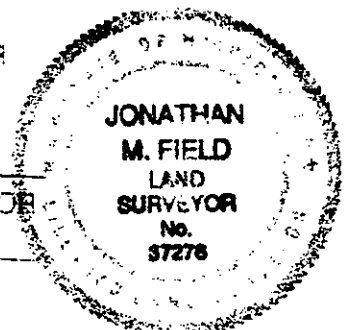

Signed by *Jonathan M. Field* Date 12-1-95
Surveyor's Michigan License No. 37276