

SURVEY & REMONUMENTATION

APR 29 1995

COMMISSION

LAND CORNER RECORDATION CERTIFICATE RECEIVED FOR RECORD

Filing Requirement of Act 74, Mich. P.A. 1970
1995 REMONUMENTATION PROGRAM

95 DEC 13 AM 8:55

For corners in BURLINGTON TWP.

LAPEER	Located In:	Corner Code #	
(County)			
1. Public Land Survey	T 10N R 11E	A-7	
	T	R	
	T	R	
	T	R	
2. Property Controlling in Section	S	T	R
	S	T	R
3. Miscellaneous Property in Sec.	S	T	R
	S	T	R
4. Lot No. _____	Recorded Plat _____		
5. Private Claims _____			

LIBER NO. 5 PAGE NO. 316
Melissa D. Vaughn
REGISTER OF DEEDS
LAPEER COUNTY MICHIGAN

Register of Deeds Stamp & File Number

	A	B	C	D	E	F	G	H	I	J	K	L	M
1													
2	6	5	4	3	2	1							
3													
4	7	8	9	10	11	12							
5													
6	18	17	16	15	14	13							
7													
8	19	20	21	22	23	24							
9													
10	30	29	28	27	26	25							
11													
12	31	32	33	34	35	36							
13													

I, JONATHAN M. FIELD, in a field survey on MARCH 19 95 do hereby certify that under requirements of P.A. 74, Michigan P.A. of 1970, the corner points mentioned in lines 1 and 2 above were in conformance with regulations and rules therefore as required in the current manual of survey instructions of the United States Department of the Interior, Bureau of Land Management or by a decree of a Court of Law and/or that the corner points mentioned in lines 3, 4 and 5 above were in conformance with the rules of the Michigan Board of Land Surveyors or by a Decree of a Court of Law; established, re-established, monumented, re-monumented, recovered, found as expressed below:

NOTE: Not more than 4 corners, all in the same town and range, may be recorded on this certificate.

- A. Description of original monument and accessories and/or subsequent restoration:**
- 1833 GLO; PARKE, D.S.; SET POST; SUGAR 16 S45W 38LKS., BEECH 5 N43W 8LKS.
 - 1974 COMMONWEALTH; SWARTS, P.S.#16945; SURVEY L.2, PG.942; SET 1/2" IRON; N10W 37.60' FE POST S10W 23.72' FE POST, S45E 29.30' FE POST
 - 1974 COMMONWEALTH; SWARTS, P.S.#16945; SURVEY L.2, PG.944; SET 1/2" RE-BAR; SAME WITS AS SURVEY ABOVE
 - 1974 SWARTS, P.S.#16945; LCRC L.2, PG.633; SET 1/2" IRON BY SINGLE PROPORTIONATE MEASUREMENT; SAME WITS AS SURVEY ABOVE
 - 1986 GRAVLIN, P.S.#23510; SURVEY L.7, PG.446; SET 1/2" IRON; SOUTH 31.80' P.POLE, S45W 33.55' W. END 12" CMP, N10W 27.75' FACE OF PHONE BOX

- B. Description of corner evidence found and/or method applied in restoring or reestablishing corner:**
- 1995 ROWE ENG.; FIELD, P.S.#37276; FND 1/2" ROD ON C/L GRAVEL ROAD E-W, 2'E. OF FENCE LINE TO N., OVERHEAD POWER LINES TO S. ALSO FND FE POSTS NW & SW AT DIST'S GIVEN BY SWARTS IN 1974 BUT POSTS ARE LEANING. ALSO FND W. END OF CMP GIVEN BY GRAVLIN IN 1986 AT APPROX. DIST. BUT IS NOW BURIED

G.L.O. NOTES FOR T9N-R11E INDICATE THAT THIS CORNER IS COMMON WITH M-7 T10N-R10E

M-7 TO M-8 2647.43' (GRAVLIN 1986) M-7 TO M-9 5304.51 (GRAVLIN)
M-7 TO M-6 2658.22' (SWARTS 1974) M-7 TO M-9 5304.44 (REI 1995)

ACCEPTED FND ROD AS A CAREFUL AND FAITHFUL PERPETUATION OF THE ORIGINAL CORNER POSITION


- C. Description of monument for corner and accessories established to perpetuate locating the position of the corner:**

A-7 SET STANDARD BRASS CAP ON FND 1/2" ROD

- S05°W, 31.35' SET NAIL W/REMON TAG IN E. FACE T.POLE
- N10°W, 28.50' TOP CENTER OF PHONE RISER
- N55°E, 23.09' SET 1/2" ROD W/CAP #37276
- N60°W, 22.90' SET 1/2" ROD W/CAP #37276
- SOUTH, 32.62' FND 1/2" ROD W/CAP #23510

PEER GROUP
APPROVED LAND CORNER
P.A. 345 OF 1990
LAPEER COUNTY

[Signature]
RAY DAVIS P.S. CC. SURVEYOR
DATE 7-13-95

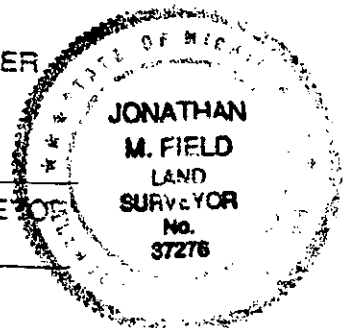

Signed by *Jonathan M. Field*
Surveyor's Michigan License No. 37276

Date 12-1-95