

APR 29 1996

COMMISSION

LAND CORNER RECORDATION CERTIFICATE
Filing Requirement of Act 74, Mich. P.A. 1970
1995 REMONUMENTATION PROGRAM

RECEIVED FOR RECORD

95 DEC 13 AM 8:56

LIBER NO. 5 PAGE NO. 317

REGISTER OF DEEDS
LAPEER COUNTY, MICHIGAN

For corners in BURLINGTON TWP.

LAPEER (County)

Located In:

Corner Code #

Table with 3 columns: Description, Township/Range/Section, and Corner Code #. Includes rows for Public Land Survey, Property Controlling in Section, and Miscellaneous Property in Sec.

Register of Deeds Stamp & File Number

4. Lot No. Recorded Plat
5. Private Claims

I, JONATHAN M. FIELD, in a field survey on MARCH 19 95 do hereby certify that under requirements of P.A. 74, Michigan P.A. of 1970, the corner points mentioned in lines 1 and 2 above were in conformance with regulations and rules therefore as required in the current manual of survey instructions of the United States Department of the Interior, Bureau of Land Management or by a decree of a Court of Law and/or that the corner points mentioned in lines 3, 4 and 5 above were in conformance with the rules of the Michigan Board of Land Surveyors or by a Decree of a Court of Law, established, re-established, monumented, re-monumented, recovered, found as expressed below:

NOTE: Not more than 4 corners, all in the same town and range, may be recorded on this certificate.

A. Description of original monument and accessories and/or subsequent restoration:

- 1833 GLO; PARKE, D.S.; SET POST; SUGAR 12 S26 1/2W 30 1/2LKS., BEECH 10 N7W 20LKS.
1986 GRAVLIN, P.S.#23510; SURVEY L.7, PG.446; SET 1/2" IRON; EAST 17.86' 8" ASH, S20E 21.95' 8" HICKORY, N40E 10.16' 6" ASH
1989 GRAVLIN, P.S.#23510; LCRC L.4, PG.259; SET 1/2" IRON; SAME WITS AS 1986 SURVEY ABOVE
1995 GRAVLIN, P.S.#23510; SURVEY L.10, PG.847; FND 1/2" IRON; S20E 21.95' 8" HICKORY, N40E 10.16' 6" ASH, N40E 3.04' 6" ASH, N85W 22.6' 8" ASH

B. Description of corner evidence found and/or method applied in restoring or reestablishing corner:

1995 ROWE ENG.; FIELD, P.S.#37276; FND 1/2" ROD AT N. FACE OF FALLEN 12" FENCE CORNER POST ALSO FND 4 WITS GIVEN BY GRAVLIN IN 1986 INDICATING THAT FND IRON IS IN SAME POSITION

G.L.O. NOTES FOR T9N-R11E IMPLY THAT THIS CORNER IS COMMON WITH M-8 T10N-R10E

M-8 TO M-9 2657.08' (GRAVLIN 1995)
M-8 TO M-7 2647.43' (GRAVLIN 1986)

ACCEPTED FND 1/2" ROD AS A CAREFUL AND FAITHFUL PERPETUATION OF THE ORIGINAL CORNER POSITION

C. Description of monument for corner and accessories established to perpetuate locating the position of the corner:


- A-8 SET STANDARD BRASS CAP ON FND 1/2" ROD
N40°E, 3.11' SET NAIL W/REMON TAG BELOW FND NAIL W/FLAG. IN SE FACE 6" ASH
N40°E, 10.20' SET NAIL W/REMON TAG BELOW FND NAIL W/FLAG. IN NW FACE 6" ASH
S80°E, 17.76' SET NAIL W/REMON TAG IN TOP OF 10" ASH STUMP
S20°E, 22.04' SET NAIL W/REMON TAG BELOW FND NAIL W/FLAG. IN E. FACE 10" OAK
N85°W, 22.64' SET NAIL W/REMON TAG BELOW FND NAIL W/FLAG. IN S. FACE 8" ASH

APPROVED LAND CORNER
PA 345 OF 1990
LAPEER COUNTY

RAY DAVIS P.S. CO. SURVEYOR
DATE 7-13-95

Signed by Jonathan M. Field
Surveyor's Michigan License No. 37276

Date 12-1-95

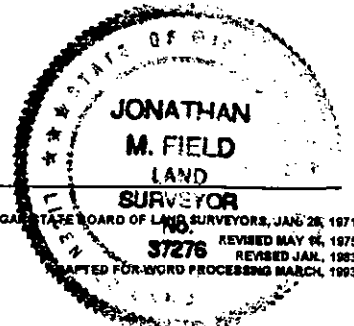

FORM APPROVED BY MICHIGAN STATE BOARD OF LAND SURVEYORS, JAN 26, 1971
REVISED MAY 96, 1975
REVISED JAN. 1983
ADAPTED FOR WORD PROCESSING MARCH, 1993