

**SURVEY &
REMONUMENTATION**

OCT 29 1996

COMMISSION

REMONUMENTATION

LAND CORNER RECORDATION CERTIFICATE
Filing Requirement of Act 74, Mich. P.A. 1970

RECEIVED FOR RECORD
96 SEP 30 PM 3:16

For corners in

| | | |
|--|-------------------------|---------------|
| <u>LAPEER</u> <small>(County)</small> | Located In: | Corner Code # |
| | 10N 11E | H-13 |
| 1. Public Land Survey | T _____ R _____ | _____ |
| | T _____ R _____ | _____ |
| | T _____ R _____ | _____ |
| | T _____ R _____ | _____ |
| 2. Property Controlling in Section | S _____ T _____ R _____ | _____ |
| | S _____ T _____ R _____ | _____ |
| 3. Miscellaneous Property in Sec. | S _____ T _____ R _____ | _____ |
| | S _____ T _____ R _____ | _____ |
| 4. Lot No. _____, Recorded Plat _____ | | |
| 5. Private Claims _____ | | |

Register of Deeds Stamp & File Number

Earl E. Gravlin
REGISTERED PROFESSIONAL SURVEYOR
LAPEER COUNTY MICHIGAN

I, EARL E. GRAVLIN AUGUST 1996,
in a field survey on _____, 19_____,

do hereby certify that under requirements of P.A. 74, Michigan P.A. of 1970, the corner points mentioned in lines 1 and 2 above were in conformance with regulations and rules therefore as required in the current manual of survey instructions of the United States Department of the Interior, Bureau of Land Management or by a decree of a Court of Law and/or that the corner points mentioned in lines 3, 4 and 5 above were in conformance with the rules of the Michigan Board of Land Surveyors or by a Decree of a Court of Law; established, re-established, monumented, re-monumented, recovered, found as expressed below:

NOTE: Not more than 4 corners, all in the same town and range, may be recorded on this certificate.

| | | | | | | | | | | | | |
|----|----|----|----|----|----|----|---|---|---|---|---|---|
| A | B | C | D | E | F | G | H | I | J | K | L | M |
| 2 | 6 | 5 | 4 | 3 | 2 | | | | | | | |
| 3 | | | | | | | | | | | | |
| 4 | 7 | 8 | 9 | 10 | 11 | 12 | | | | | | |
| 5 | | | | | | | | | | | | |
| 6 | 18 | 17 | 16 | 15 | 14 | 13 | | | | | | |
| 7 | | | | | | | | | | | | |
| 8 | 19 | 20 | 21 | 22 | 23 | 24 | | | | | | |
| 9 | | | | | | | | | | | | |
| 10 | 30 | 29 | 28 | 27 | 26 | 25 | | | | | | |
| 11 | | | | | | | | | | | | |
| 12 | 31 | 32 | 33 | 34 | 35 | 36 | | | | | | |
| 13 | | | | | | | | | | | | |

A. Description of original monument and accessories and/or subsequent restoration:

History: Parke, 1833, Set 1/4 Post, Bearings B. Ash, 6 N.82E., Maple 9 N.671/2 W.35. County Surveyor none. Act 74 none. Recorded Surveyors Gravlin Land Survey, Liber 11, Page 304, Set Iron, N50°W 83.10' S/S 8" Ash, N05°E 33.72' On Face of West Leg of Sign, N70°E 184.44' N/S Power Pole.

B. Description of corner evidence found and/or method applied in restoring or reestablishing corner:


GRAVEL ROAD TO WEST, GRAVEL ROAD TO NORTH, ABANDONED ROAD BED TO EAST, FOUND 1/2" IRON. G-13 TO H-13 2650.89, H-13 TO I-13 2647.89, H-1 NOT FOUND

PEER GROUP
APPROVED LAND CORNER
PA 345 OF 1980
LAPEER COUNTY

Ray Davis
RAY DAVIS P.S. CO. SURVEYOR
DATE 9-10-96

C. Description of monument for corner and accessories established to perpetuate locating the position of the corner:

H-13 SOUTH 1/4 CORNER, SECTION 34, T10N-R11E
FOUND IRON, SET BRASS CAP
N50°W 83.12' NAIL AND TAG S/S 8" ASH
N70°E 184.44' NAIL AND TAG N/S POWER POLE
S80°W 83.02' NE COR TELE PED.
N05°E 33.72' FACE ON WEST LEG OF SIGN

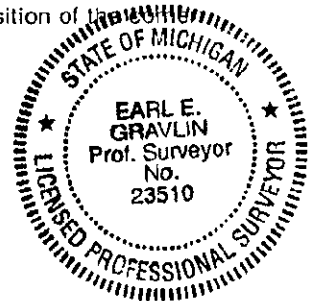

Signed by *Earl E. Gravlin* Date 9-10-96
Surveyor's Michigan License No. 23510