

**SURVEY &  
REMONUMENTATION**

OCT 29 1996

COMMISSION

REMONUMENTATION  
LAND CORNER RECORDATION CERTIFICATE  
Filing Requirement of Act 74, Mich. P.A. 1970

RECEIVED FOR RECORD  
96 OCT -2 AM 11:04

For corners in

<u>LAPEER</u> <small>(County)</small>	Located In:	Corner Code #
1. Public Land Survey	T <u>10N</u> R <u>11E</u>	<u>I-13</u>
	T _____ R _____	_____
	T _____ R _____	_____
	T _____ R _____	_____
2. Property Controlling in Section	S _____ T _____ R _____	_____
	S _____ T _____ R _____	_____
3. Miscellaneous Property in Sec.	S _____ T _____ R _____	_____
	S _____ T _____ R _____	_____
4. Lot No. _____, Recorded Plat _____		
5. Private Claims _____		

*Melissa D. Vaughn*  
REGISTER OF DEEDS  
LAPEER COUNTY, MICHIGAN

Register of Deeds Stamp & File Number

I, EARL E. GRAVLIN, in a field survey on AUGUST, 19 96, do hereby certify that under requirements of P.A. 74, Michigan P.A. of 1970, the corner points mentioned in lines 1 and 2 above were in conformance with regulations and rules therefore as required in the current manual of survey instructions of the United States Department of the Interior, Bureau of Land Management or by a decree of a Court of Law and/or that the corner points mentioned in lines 3, 4 and 5 above were in conformance with the rules of the Michigan Board of Land Surveyors or by a Decree of a Court of Law; established, re-established, monumented, re-monumented, recovered, found as expressed below:

	A	B	C	D	E	F	G	H	I	J	K	L	M
2	6		5		4		3		2		1		
3													
4	7		8		9		10		11		12		
5													
6	18		17		16		15		14		13		
7													
8	19		20		21		22		23		24		
9													
10	30		29		28		27		26		25		
11													
12	31		32		33		34		35		36		
13													

**NOTE: Not more than 4 corners, all in the same town and range, may be recorded on this certificate.**

A. Description of original monument and accessories and/or subsequent restoration:

History: Parke, 1833, Set Post Cor. Sections 34, 35, Bearings Elm, 18 N.36 1/2E 21, Do. 12 N.43W. 50. Jog 1.83 CH East (120.78'). County Surveyor none. Act 74 none. Recorded Surveys Gravlín Land Survey, Liber 11, Page 304, Found corner stone, replaced with 1/2" iron and cap., S05°W 12.68' W/S 18" Maple, S45°E 18.36' W/S 8" Maple, N80°E 10.16' S/S 6" Elm.

B. Description of corner evidence found and/or method applied in restoring or reestablishing corner:


ABANDONED ROAD BED EAST AND WEST, FOUND IRON. H-13 TO I-13 2647.89, I-13 TO J-13 2656.70 AND I-13 TO I-1 120.78

PEER GROUP  
APPROVED LAND CORNER  
PA 345 OF 1990  
LAPEER COUNTY

*Ray J. Davis*  
RAY DAVIS P.S. CO. SURVEYOR  
DATE 9-10-96

C. Description of monument for corner and accessories established to perpetuate locating the position of the corner:

I-13, SOUTHEAST CORNER, SECTION 34, T10N-R11E  
FOUND IRON, SET BRASS CAP  
S05°W 12.72' NAIL AND TAG W/S 18" MAPLE  
S45°E 18.46' NAIL AND TAG W/S 8" MAPLE  
N80°E 10.20' NAIL AND TAG S/S 6" ELM  
EAST 120.78' BOLT SPIKE NE COR 3-9-11  
N05°E 8.06' NAIL AND TAG W/S 4" MAPLE

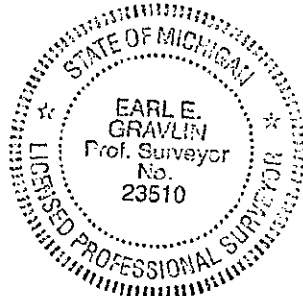

Signed by *Earl E. Gravlín*  
Surveyor's Michigan License No. 23510

Date 10-1-96