

SURVEY &
REMONUMENTATION

1993

COMMISSION

REMONUMENTATION
LAND CORNER RECORDATION CERTIFICATE
Filing Requirement of Act 74, Mich. P.A. 1970

RECEIVED FOR RECORD

93 DEC 22 PM 3:10

LIBER # 5 FILE NO. 39

Melissa A. Mas
REGISTERED PROFESSIONAL SURVEYOR
LAPEER

For corners in

<u>LAPEER</u> <small>County</small>	Located In:	Corner Code #
1. Public Land Survey	T <u>10N</u> R <u>11E</u>	<u>M-12</u>
	T _____ R _____	_____
	T _____ R _____	_____
	T _____ R _____	_____
2. Property Controlling in Section	S _____ T _____ R _____	_____
	S _____ T _____ R _____	_____
3. Miscellaneous Property in Sec.	S _____ T _____ R _____	_____
	S _____ T _____ R _____	_____
4. Lot No. _____, Recorded Plat _____		
5. Private Claims _____		

Register of Deeds Stamp & File Number

I, EARL E. GRAVLIN, in a field survey on OCTOBER, 19 93, do hereby certify that under requirements of P.A. 74, Michigan P.A. of 1970, the corner points mentioned in lines 1 and 2 above were in conformance with regulations and rules therefore as required in the current manual of survey instructions of the United States Department of the Interior, Bureau of Land Management or by a decree of a Court of Law and/or that the corner points mentioned in lines 3, 4 and 5 above were in conformance with the rules of the Michigan Board of Land Surveyors or by a Decree of a Court of Law: established, re-established, monumented, re-monumented, recovered, found as expressed below:

NOTE: Not more than 4 corners, all in the same town and range, may be recorded on this certificate.

	A	B	C	D	E	F	G	H	I	J	K	L	M
2	6	5	4	3	2	1							
3													
4	7	8	9	10	11	12							
5													
6	18	17	16	15	14	13							
7													
8	19	20	21	22	23	24							
9													
10	30	29	28	27	26	25							
11													
12	31	32	33	34	35	36							
13													

A. Description of original monument and accessories and/or subsequent restoration:


M-12. East quarter corner Section 36 History: East and South town lines run by Hervey Parke, 1834. Pages 486 and 487 Subdivision of township run by Hiram Burnham, third quarter, 1834. page 496-498. Witnesses Sugar 24 N27°W .34 Elm 12 S37°W .47 set post. County Surveyors Record: Book 2, page 146, Stone East quarter corner

B. Description of corner evidence found and/or method applied in restoring or reestablishing corner:

Site conditions: Flat farmland All fences removed within last 10 years by property owners. Found steel fence post placed in apparent location of corner post. Found rocks and wood fragments. Set 1/2 " iron. Nothing within 200 feet to witness. Corn not harvested.
MEASUREMENT M-12 TO M-13 2632.91' M-12 TO M-11 2639.90'

C. Description of monument for corner and accessories established to perpetuate locating the position of the corner:

October 20, 1993
M-12
Set 1/2 " iron, with brass cap.
S 71°E 346.60' SOUTH END 72" C.M.P.
S 75°E 340.46' NORTH END 72" C.M.P.
N 88°W 675.64' NAIL & TAG 12" ASH
N 64°W 750.44' NAIL & TAG 11" ASH

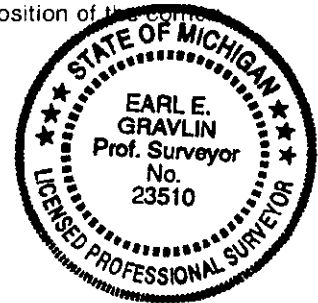

Signed by *[Signature]* Date 12/02/93
Surveyor's Michigan License No. 23510