

**SURVEY &  
REMONUMENTATION**

OCT 29 1996

**COMMISSION**

REMONUMENTATION

**LAND CORNER RECORDATION CERTIFICATE**  
Filing Requirement of Act 74, Mich. P.A. 1970

RECEIVED FOR RECORD  
29 SEP 30 PM 3:11

For corners in

LAPEER

(County)

Located In:

Corner Code ##

10N 12E

G-13

- |                                    |   |       |   |       |       |
|------------------------------------|---|-------|---|-------|-------|
| 1. Public Land Survey              | T | _____ | R | _____ | _____ |
|                                    | T | _____ | R | _____ | _____ |
|                                    | T | _____ | R | _____ | _____ |
|                                    | T | _____ | R | _____ | _____ |
| 2. Property Controlling in Section | S | _____ | T | _____ | R     |
|                                    | S | _____ | T | _____ | R     |
| 3. Miscellaneous Property in Sec.  | S | _____ | T | _____ | R     |
|                                    | S | _____ | T | _____ | R     |

*Richard DeLoach*  
REGISTER OF DEEDS  
LAPEER COUNTY, MICHIGAN

Register of Deeds Stamp & File Number

4. Lot No. \_\_\_\_\_, Recorded Plat \_\_\_\_\_  
5. Private Claims \_\_\_\_\_

EARL E. GRAVLIN

AUGUST

96

I, \_\_\_\_\_, in a field survey on \_\_\_\_\_, 19 \_\_\_\_\_, do hereby certify that under requirements of P.A. 74, Michigan P.A. of 1970, the corner points mentioned in lines 1 and 2 above were in conformance with regulations and rules therefore as required in the current manual of survey instructions of the United States Department of the Interior, Bureau of Land Management or by a decree of a Court of Law and/or that the corner points mentioned in lines 3, 4 and 5 above were in conformance with the rules of the Michigan Board of Land Surveyors or by a Decree of a Court of Law; established, re-established, monumented, re-monumented, recovered, found as expressed below:

	A	B	C	D	E	F	G	H	I	J	K	L	M
2	6		5		4		3		2		1		
3													
4	7		8		9		10		11		12		
5													
6	18		17		16		15		14		13		
7													
8	19		20		21		22		23		24		
9													
10	30		29		28		27		26		25		
11													
12	31		32		33		34		35		36		
13													

**NOTE: Not more than 4 corners, all in the same town and range, may be recorded on this certificate.**

**A. Description of original monument and accessories and/or subsequent restoration:**

History: Parke, 1833, Cor. Sections 33, 34 B. Ash 9N.57E.9, Cedar 16N.46W.22, JOG, 2.32 (153.12) East. County Surveyor Nothing. Act 74 none. Recorded Surveys Gravlin Land Survey, Liber 10, Page 527.

**B. Description of corner evidence found and/or method applied in restoring or reestablishing corner:**


GRAVEL ROAD, FENCE ROW TO NORTH. FOUND IRON G-13 TO H-13 2657.72 AND G-13 TO G-1 163.35

PEER GROUP  
APPROVED LAND CORNER  
PA 345 OF 1990  
LAPEER COUNTY

*Ray Davis*  
RAY DAVIS P.S. CO. SURVEYOR  
DATE 9-10-96

**C. Description of monument for corner and accessories established to perpetuate locating the position of the corner:**

G-13, SOUTHWEST CORNER SECTION 34, T10N-R12E  
FOUND IRON SET BRASS CAP  
S70°E 55.37' S END 36" CMP  
N70°E 52.20' N END 36" CMP  
N70°W 64.80' NAIL AND TAG S/S 8" ELM  
N60°E 72.23' SW COR TELE PED  
EAST 163.35' G-1 T9N-R12E

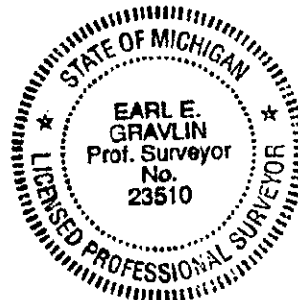

Signed by *[Signature]* Date 9-10-96  
Surveyor's Michigan License No. 23510