

SURVEY & REMONUMENTATION

OCT 29 1995

COMMISSION

REMONUMENTATION

LAND CORNER RECORDATION CERTIFICATE
Filing Requirement of Act 74, Mich. P.A. 1970

RECEIVED FOR RECORD
96 SEP 30 PM 3:12

For corners in

LAPPEER <small>(County)</small>	Located In:		Corner Code #
	10N	12E	
1. Public Land Survey	T _____	R _____	H-13
	T _____	R _____	
	T _____	R _____	
	T _____	R _____	
2. Property Controlling in Section	S _____	T _____	R _____
	S _____	T _____	R _____
3. Miscellaneous Property in Sec.	S _____	T _____	R _____
	S _____	T _____	R _____
4. Lot No. _____, Recorded Plat _____			
5. Private Claims _____			

Robert D. ...
REGISTER OF DEEDS
LAPPEER COUNTY, MICHIGAN

Register of Deeds Stamp & File Number

	A	B	C	D	E	F	G	H	I	J	K	L	M
2	6	5	4	3	2	1							
3													
4	7	8	9	10	11	12							
5													
6	18	17	16	15	14	13							
7													
8	19	20	21	22	23	24							
9													
10	30	29	28	27	26	25							
11													
12	31	32	33	34	35	36							
13													

I, EARL E. GRAVLIN AUGUST 96, 1996, in a field survey on _____, do hereby certify that under requirements of P.A. 74, Michigan P.A. of 1970, the corner points mentioned in lines 1 and 2 above were in conformance with regulations and rules therefore as required in the current manual of survey instructions of the United States Department of the Interior, Bureau of Land Management or by a decree of a Court of Law and/or that the corner points mentioned in lines 3, 4 and 5 above were in conformance with the rules of the Michigan Board of Land Surveyors or by a Decree of a Court of Law; established, re-established, monumented, re-monumented, recovered, found as expressed below:

NOTE: Not more than 4 corners, all in the same town and range, may be recorded on this certificate.

A. Description of original monument and accessories and/or subsequent restoration:

History: Parke, 1833, Set quarter Section Post, Bearings Hemlock 20 N.82E 7, Do. 10 N.52W32 the bearings trees are marked. County Surveyor none. Act 74 none. Recorded Surveys Gravelin, Liber 10, Pages 527-528 Set Iron 6'± S C/L Stiles Road, 5'±W C/L Ragan Road on Split, Between SE Cor and SW Cor, S10°E 8.66' W. Leg Sign, N20°W 41.07' SE Cor Tele Ped., N50°W 58.15' 8" Elm.


B. Description of corner evidence found and/or method applied in restoring or reestablishing corner:

FOUND IRON 6'± SOUTH C/L STILES ROAD AND 5'± WEST C/L RAGAN ROAD, GRAVEL ROAD EAST AND WEST, GRAVEL ROAD NORTH, G-13 TO H-13 2657.71, H-13 TO I-13 2657.18 AND H-13 TO H-1 161.21

PEER GROUP
APPROVED LAND CORNER
PA 345 OF 1990
LAPPEER COUNTY
Ray Davis
RAY DAVIS P.S. CO. SURVEYOR
DATE 9-10-96

C. Description of monument for corner and accessories established to perpetuate locating the position of the corner:

H-13, S 1/4 CORNER, SECTION 34, T10N-R12E
FOUND IRON 6'± SOUTH C/L STILES ROAD AND 5'± WEST C/L RAGAN ROAD, SET BRASS CAP
S10°E 8.66' FACE WEST LEG SIGN,
N20°W 40.60' SE COR TELE PED.,
N50°W 58.05' NAIL AND TAG S/S 8" ELM
N75°W 75.80' NAIL AND TAG S/S 8" ELM
EAST 161.21 H-1 T9N-R12E

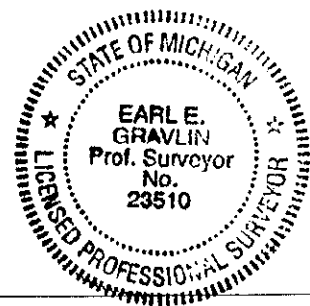

Signed by *Earl E. Gravelin*
Surveyor's Michigan License No. 23510

Date 9-10-96