SURVEY & REMONUMENTATION

APR 2 9 1996

COMMISSION

REMONUMENTATION

LAND CORNER RECORDATION CERTIFICATE

Filing Requirement of Act 74, Mich. P.A. 1970

RECEIVED FOR RECORD

95 SEP -7 PM 3:03

LIBER NO. 5 PAGE NO. 269

Melissa DeVaugh

REGISTER OF DEEDS
LAPEER COUNTY, MICHIGAN

Register of Deeds Stamp & File Number

For corners in LAPEER (County)

	Located In:	Corner Code #
	Burnside North 10N 12E	K-13
1. Public Land Survey	T ____ R ____	
	T ____ R ____	
	T ____ R ____	
	T ____ R ____	
2. Property Controlling	S ____ T ____ R ____	
in Section	S ____ T ____ R ____	
3. Miscellaneous	S ____ T ____ R ____	
Property in Sec.	S ____ T ____ R ____	

4. Lot No. _____ , Recorded Plat _____

5. Private Claims _____

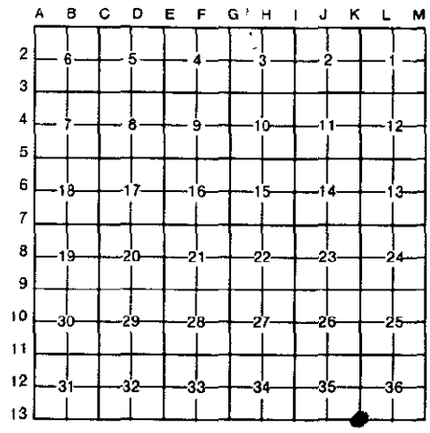

I, Earl E. Gravlin, in a field survey on July 19th, 19 95, do hereby certify that under requirements of P.A. 74, Michigan P.A. of 1970, the corner points mentioned in lines 1 and 2 above were in conformance with regulations and rules therefore as required in the current manual of survey instructions of the United States Department of the Interior, Bureau of Land Management or by a decree of a Court of Law and/or that the corner points mentioned in lines 3, 4 and 5 above were in conformance with the rules of the Michigan Board of Land Surveyors or by a Decree of a Court of Law; established, re-established, monumented, re-monumented, recovered, found as expressed below:

NOTE: Not more than 4 corners, all in the same town and range, may be recorded on this certificate.

A. Description of original monument and accessories and/or subsequent restoration:

History: Parke 1833 Set Post Beech 12 N67.5W 47 Do 12 N44E 21, County Surveyor None, Act 74 None, Recorded Surveys None, Unrecorded Surveys None. Road Commission Nothing. Drain Commission Nothing.

B. Description of corner evidence found and/or method applied in restoring or reestablishing corner:

Site Conditions: Found 1/2" Rod in Gravel Road, Rolling Farmland, Gravel Road East, North and West. K-13 to K-1 East 40.38. GLO 55 Links, K13 to J13 2653.86 K-13 to L-13 2665.13.

PEER GROUP
APPROVED LAND CORNER
PA 345 OF 1990
LAPEER COUNTY

RAY DAVIS P.S. CO. SURVEYOR
DATE 7-13-95

C. Description of monument for corner and accessories established to perpetuate locating the position of the corner:

July 19th, 1995
FOUND 1/2" RE-ROD BENT, REPLACED WITH 1/2" RE-ROD AND BRASS CAP
N43°W 76.37' NAIL & TAG S SIDE POWER POLE
N36°E 61.00' NAIL & TAG N SIDE WOODPOST TELE PED.
EAST 40.38' FOUND 1/2" ROD
S26°W 36.10' FACE BURIED CABLE SIGN

Signed by _____ Date 8-17-95

Surveyor's Michigan License No. 23570

FORM APPROVED BY MICHIGAN STATE BOARD OF LAND SURVEYORS, JAN. 28, 1971
REVISED MAY 14, 1975
REVISED JAN., 1983