

Lansing - Forestry
LEELANAU Co.
Run Cop.

LAND CORNER RECORDATION CERTIFICATE
FILING REQUIREMENT OF ACT 74, MICH. P.A. 1970

FOR CORNERS OF--	LOCATED IN--	CORNER CODE NUMBER
1. PUBLIC LAND SURVEY	T. 28 N. 8., R. 13 E. W.	1-13
2. PROPERTY CONTROLLING IN SECTION 34	T. 28 N. 8., R. 13 E. W.	U.S.M.C. 1093.14' W of I-13 U.S.M.C. 208:00 E of H-13
3. MISCELLANEOUS PROPERTY IN SECTION	T. S., R. E. W.	
4. LOT NO. _____, RECORDED PLAT _____		
5. PRIVATE CLAIMS _____		

REGISTER OF DEEDS STAMP AND FILING NUMBER

I, Carl F. Roser do hereby certify that under requirements of P.A. 74, Michigan P.A. of 1970, the corner points mentioned in lines 1 and 2 above (identified with circles on index code diagram - over) were, in a field survey on 4-5 1973, established, re-established, monumented, re-monumented, recovered or restored as expressed below and in conformance with regulations and rules therefore as required in the current manual of survey instructions of the United States Department of the Interior, Bureau of Land Management or by a decree of a court of law. Furthermore, that the corner points mentioned in lines 3, 4 and 5 above were, in a field survey on 19, found, recovered, restored, established or re-established as expressed below and in conformance with the rules of the Michigan State Board of Registration for Land Surveyors or, by a Decree of a Court of law:

A. Description of original monument and accessories and/or subsequent restoration:

B. Description of corner evidence found and/or method applied in restoring or re-establishing corner:

1-13 Reestablished corner in road intersection. Fits ROW fence remains.

M.C. W of 1-13 Restored U.S. meander corner (E. side Davis Lk) on line and prop. dist. to U.S. between the SE S-34 and the SW S-34.

M.C. E of H-13 Restored U.S. Meander Corner (W. Side Davis Lake) on line and prop. dist. to U.S., between SE Sec. 34 and SW Sec. 34.

C. Description of monument for corner and accessories established to perpetuate locating the position of the corner:

1-13	M.C. W of 1-13	MC E of H-13
Set DNR Mon buried 8.5'	Set DNR Mon & Cedar Gd Post	Set DNR Mon & Ced. Gd. Post
20" Maple S47E 55.46'	7" Hemlock N 7E 10.95'	4" Hemlock S17E 35.0'
14" Maple S43E 93.80'	9" Maple S 4W 32.75'	5" Maple S21W 33.5'
8" Maple N50W 53.38'	9" W. Pine S49W 32.10'	5" Maple N45W 6.3'
In Int. N-S-E-W Grav. Co. Rd		148' East to water's edge.
Set Ced. Post w/loc tag S45W 47'		


SIGNED BY Carl F. Roser DATE 7-16-73

SURVEYOR'S MICHIGAN REGISTRATION NO. 12028

FOR STATE AND UNITED STATES AGENCIES:

SIGNED BY _____ DATE _____
CHIEF OF SURVEY PARTY

APPROVED AND SIGNED BY _____ DATE _____
MICHIGAN REGISTERED LAND SURVEYOR

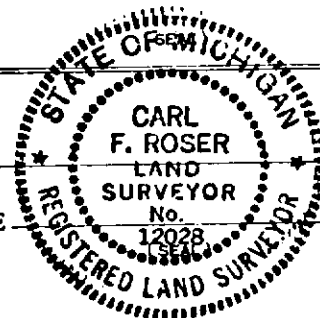

SURVEYOR'S MICHIGAN REGISTRATION NO. _____