LAND CORNER RECORDATION CERTIFICATE

Filing Requirement of Act 74, Mich. P.A. 1970

For corners in
Leelanau
(County)

	Located In:	Corner Code ##
1. Public Land Survey	T 28N R 13W	K-9
	T 28N R 13W	J-9
	T 28N R 13W	I-11
	T 28N R 13W	I-12
2. Property Controlling	S ___ T ___ R ___	
in Section	S ___ T ___ R ___	
3. Miscellaneous	S ___ T ___ R ___	
Property in Sec.	S ___ T ___ R ___	

Register of Deeds Stamp & File Number

4. Lot No. _____ , Recorded Plat _____
5. Private Claims _____

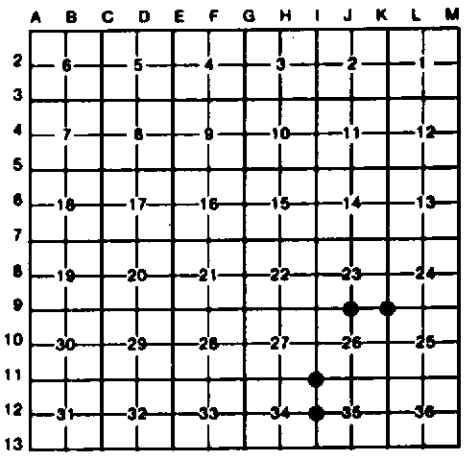

I, Carl F. Roser, in a field survey on April 30, 19 87, do hereby certify that under requirements of P.A. 74, Michigan P.A. of 1970, the corner points mentioned in lines 1 and 2 above were in conformance with regulations and rules therefore as required in the current manual of survey instructions of the United States Department of the Interior, Bureau of Land Management or by a decree of a Court of Law and/or that the corner points mentioned in lines 3, 4 and 5 above were in conformance with the rules of the Michigan Board of Land Surveyors or by a Decree of a Court of Law; established, re-established, monumented, re-monumented, recovered, found as expressed below:

NOTE: Not more than 4 corners, all in the same town and range, may be recorded on this certificate.

C. Continued:

A

I-11

Found 3/4" Iron

*Power Pole	N05°W	132.47'
*24" Maple	N80°E	135.52'
*Tag in post by tele. stand	N32°E	85.90'
*N. post - Loomis Camp Grd. sign	S30°W	71.79'

*= MDOT 1984 wits. per DNR survey

I-12

*3/4" x 40" pipe

*Nail in top DNR cedar post	N85°W	32.63'
*Top of W. cor RR rail Cor fn post	S82°E	35.63'
*Chsl'd crows foot SW edge RR rail gatepost	S15°E	109.97'
* 3" Red Pine	N62°E	47.22'
Power Pole	N14°E	111.59'

* = Pipe set & wit by MDOT (1984)

B. Description of corner evidence found and/or method applied in restoring or reestablishing corner:

K-9 - Corner established in 1969 Dept. Retracement Survey in this area (Project #68-34). Corner also tied-in during current survey of Section 26 & 35.

J-9 - Recovered 1½" pipe during 1969 Dept. retracement survey in this area. Corner also tied-in during current survey of Section 26 & 35. Corner is in approx. intersection of rds. E-W-N and in line with old fence to south.

I-11 - Found 3/4" solid iron in 1983 in approx. ctr. of E-W B. Top road (M-72). Corner USED & ACCEPTED AS NE COR. OF SEC. 34 IN CERT. SURVEY OF RECORD.

I-12 - This corner was established in 1973 DNR survey of Section 3, T27N-R13W, Davis Lake Survey (was later destroyed by road construction). M.D.O.T. (1984) fd. 3/8" iron & replaced with 3/4" x 40" pipe (fits 1973 DNR position).

C. Description of monument for corner and accessories established to perpetuate locating the position of the corner:

K-9

Dept. mon. buried, raised w/ 1" x 9" pipe w/RLS cap

26" Maple	S72°E	93.14'
9" Maple	S34°E	62.60'
36" Maple	S80°W	107.05'
Fn cor post	N48°E	53.1'

J-9

Fd 1/2" rerod over strong mag. pull

10" N. Pine	N24°E	120.58'
18" Apple	S66°E	98.20'
Power Pole	S65°W	94.27'
4" White Pine	S16°W	62.35'

STATE OF MICHIGAN
CARL F. ROSER
LAND SURVEYOR
No. 12028
REGISTERED LAND SURVEYOR

Signed by Carl F. Roser 8-19-87 Date _____

Surveyor's Michigan License No. 12028

FORM APPROVED BY MICHIGAN STATE BOARD OF LAND SURVEYORS
REVISED JAN., 1983