

1994 DEC 30 AM 10:40

*Barbara Kirt*  
 REGISTER OF DEEDS

#396

LIBER 2 PAGE 93

Register of Deeds Stamp & File Number

LAND CORNER RECORDATION CERTIFICATE  
 Filing Requirement of Act 74, Mich. P.A. 1970

For corners in

Leelanau (County)

Located in:

Corner Code #

1. Public Land Survey T 29N R 12W C-1  
 T \_\_\_\_\_ R \_\_\_\_\_  
 T \_\_\_\_\_ R \_\_\_\_\_  
 T \_\_\_\_\_ R \_\_\_\_\_
2. Property Controlling S \_\_\_\_\_ T \_\_\_\_\_ R \_\_\_\_\_  
 in Section S \_\_\_\_\_ T \_\_\_\_\_ R \_\_\_\_\_
3. Miscellaneous S \_\_\_\_\_ T \_\_\_\_\_ R \_\_\_\_\_  
 Property in Sec. S \_\_\_\_\_ T \_\_\_\_\_ R \_\_\_\_\_

4. Lot No. \_\_\_\_\_, Recorded Plat \_\_\_\_\_  
 5. Private Claims \_\_\_\_\_

I, Steven P. Bye, in a field survey on December 19, 19 94, do hereby certify that under requirements of P.A. 74, Michigan P.A. of 1970, the corner points mentioned in lines 1 and 2 above were in conformance with regulations and rules therefore as required in the current manual of survey instructions of the United States Department of the Interior, Bureau of Land Management or by a decree of a Court of Law and/or that the corner points mentioned in lines 3, 4 and 5 above were in conformance with the rules of the Michigan Board of Land Surveyors or by a Decree of a Court of Law; established, re-established, monumented, re-monumented, recovered, found as expressed below:

**NOTE: Not more than 4 corners, all in the same town and range, may be recorded on this certificate.**

A. Description of original monument and accessories and/or subsequent restoration:

- C-1: Northwest corner of Section 5  
 G.L.O. notes "93.91 intersect North boundary 93 links to West of post. Set post corner to Sections 5 & 6.  
 Beech 16 - S 35 W, 56 links  
 Sugar 12 - S 59 E, 32 links

B. Description of corner evidence found and/or method applied in restoring or reestablishing corner:

- C-1: Northwest corner of Section 5  
 Iron bar found in 1976. National Park Service cap found placed in concrete, 50' Northwest of the centerline of Overby Road.

Witnesses of record:  
 15" oak - S 17 W, 2.63'  
 10" Oak - East, 18.44'  
 12" Oak - N 45 E, 39.13'  
 6" Oak - N 35 W, 30.09'


APPROVED LAND CORNER  
 P.A. 345 OF 1990  
 LEELANAU COUNTY

DATE: 9-7-94  
 COUNTY REP. H. M. O'Hara

C. Description of monument for corner and accessories established to perpetuate locating the position of the corner:

- C-1: Northwest corner of Section 5  
 National park Service cap found in concrete accepted by the Leelanau County Remonumentation Peer Review Group, September 7, 1994, and not remonumented.

Existing witnesses:  
 14" Oak - S 15 W, 2.63'  
 10" Oak - N 85 E, 18.44'  
 13" Oak - N 45 E, 39.10'  
 6" Oak - N 30 W, 30.09'

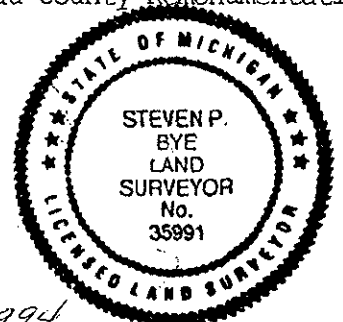

Signed by Steven P. Bye Date December 22, 1994  
 Surveyor's Michigan License No. 35991

# 396