

LAND CORNER RECORDATION CERTIFICATE

STATE OF MICHIGAN
COUNTY OF LEELANAU
RECEIVED FOR RECORD

REMONUMENTATION
SURVEY & FILING
COMMISSION
APR 10 1995

1994 DEC 30 AM 10:40

Leelanau County
FOR CORNERS OF:

	LOCATED IN—:	CORNER CODE NUMBER
1. PUBLIC LAND SURVEY	T. 29N N. S., R. 12W E. W.	C-2
2. PROPERTY CONTROLLING IN SECTION	T. _____ N. S., R. _____ E. W.	_____
3. MISCELLANEOUS PROPERTY IN SECTION	T. _____ N. S., R. _____ E. W.	_____
4. LOT NO. _____, RECORDED PLAT _____		
5. PRIVATE CLAIMS _____		

Barbara Kirt
REGISTER OF DEEDS

#397

LIBER 2 PAGE 94

REGISTER OF DEEDS STAMP AND FILING NUMBER

I, Steven P. Bye, do hereby certify that under requirements of P.A. 74, Michigan P.A. of 1970, the corner points mentioned in lines 1 and 2 above were, in a field survey on November 29, 1994, established, re-established, monumented, re-monumented, recovered or restored as expressed below and in conformance with regulations and rules therefore as required in the current manual of survey instructions of the United States Department of the Interior, Bureau of Land Management or by a decree of a court of law. Furthermore, that the corner points mentioned in lines 3, 4 and 5 above were, in a field survey on _____, 19____, found, recovered, restored, established or re-established as expressed below and in conformance with the rules of the Michigan State Board of Registration for Land Surveyors or, by a Decree of a Court of law:

A. Description of original monument and accessories and/or subsequent restoration:

C-2: West 1/4 corner of Section 5
 G.L.O. notes "1/4 post"
 Beech 8 - N 83 E, 20 links
 Sugar 10 - S 67 W, 20 links
 Greene Brothers field notes "stone with 'X' ... stone found at corner fences East & West, & North, replaced with a concrete monument. (BREHMER)
 Witnesses: 8" Elm - S 77 30' W, 18.3'
 8" Apple at NE corner of orchard - S 60 E, 38.4'
 10" Apple (N tree in second row from East) - South 22.3'

B. Description of corner evidence found and/or method applied in restoring or re-establishing corner:

C-2: West 1/4 corner of Section 5
 National Park Service cap in concrete placed over a 4 x 4 concrete monument.
 Witnesses of record:
 10" Apple - South 22.30'
 8" Apple - S 60 E, 38.14'
 8" Elm - S 77 W, 18.30'

APPROVED LAND CORNER
P.A. 345 OF 1990
LEE LANAU COUNTY
DATE: 9-7-94
COUNTY REP. W. McO'Hara

C. Description of monument for corner and accessories established to perpetuate locating the position of the corner:

C-2: West 1/4 corner of Section 5
 National Park Service cap in concrete placed over the top of a 4 x 4 square concrete monument accepted by the Leelanau County Remonumentation Peer Review Group, September 7, 1994, and not remonumented.
 Existing witnesses:
 9" Oak - N 10 E, 4.04'
 13" Oak - S 45 E, 26.37'
 10" Ash - N 58 W, 24.52'
 14" Oak - S 55 E, 16.76'


SIGNED BY Steven P. Bye DATE December 20, 1994

SURVEYOR'S MICHIGAN REGISTRATION NO. 35991

FOR STATE AND UNITED STATES AGENCIES:

SIGNED BY _____ DATE _____
CHIEF OF SURVEY PARTY

APPROVED AND SIGNED BY _____ DATE _____
MICHIGAN REGISTERED LAND SURVEYOR

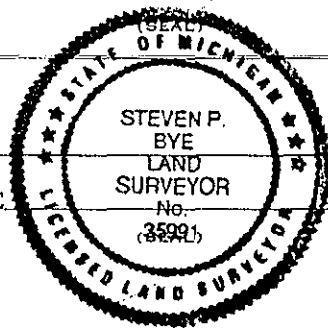

SURVEYOR'S MICHIGAN REGISTRATION NO. _____

397