SURVEY & REMONUMENTATION
APR 1 0 1995
COMMISSION

STATE OF MICHIGAN
COUNTY OF LEELANAU
RECEIVED FOR RECORD
1994 DEC 30 AM 10: 41
Barbara Kirt
REGISTER OF DEEDS

#398

LIBER 2 PAGE 95

Register of Deeds Stamp & File Number

LAND CORNER RECORDATION CERTIFICATE

Filing Requirement of Act 74, Mich. P.A. 1970

For corners in Leelanau (County)

	Located In:	Corner Code ##
1. Public Land Survey	T 29N R 12W	D-1
	T ___ R ___	
	T ___ R ___	
	T ___ R ___	
2. Property Controlling	S ___ T ___ R ___	
in Section	S ___ T ___ R ___	
3. Miscellaneous	S ___ T ___ R ___	
Property in Sec.	S ___ T ___ R ___	

4. Lot No. _____, Recorded Plat _____
5. Private Claims _____

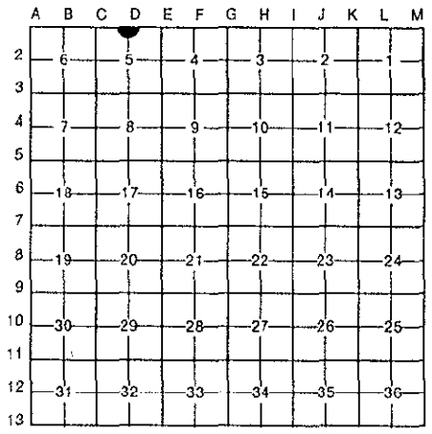

I, Steven P. Bye, in a field survey on November 16, 19 94, do hereby certify that under requirements of P.A. 74, Michigan P.A. of 1970, the corner points mentioned in lines 1 and 2 above were in conformance with regulations and rules therefore as required in the current manual of survey instructions of the United States Department of the Interior, Bureau of Land Management or by a decree of a Court of Law and/or that the corner points mentioned in lines 3, 4 and 5 above were in conformance with the rules of the Michigan Board of Land Surveyors or by a Decree of a Court of Law; established, re-established, monumented, re-monumented, recovered, found as expressed below:

NOTE: Not more than 4 corners, all in the same town and range, may be recorded on this certificate.

A. Description of original monument and accessories and/or subsequent restoration:

D-1: North 1/4 corner of Section 5
Corner not originally monumented by G.L.O.

B. Description of corner evidence found and/or method applied in restoring or reestablishing corner:

D-1: North 1/4 corner of Section 5
Iron bar and cap #19846 found. Corner was set by single proration between closing corners and on Township line.

Record witnesses:
8" Ash - N 75 E, 13.20'
16" Oak - S 15 E, 22.97'
12" Oak - N 45 W, 17.44'

APPROVED LAND CORNER
P.A. 345 OF 1990
LEELANAU COUNTY
DATE: 7-28-94
COUNTY REP. K. M. O'Neill

C. Description of monument for corner and accessories established to perpetuate locating the position of the corner:

D-1: North 1/4 corner of Section 5
Iron bar and cap #19846 accepted by the Leelanau County Remonumentation Peer Review Group, July 28, 1994, and replaced with a 3/4" i.d. galvanized iron pipe 3' long with a brass cap.

17" Oak - S 15 E, 22.67'
14" Oak - N 45 W, 17.44'
12" Ironwood - N 45 E, 25.91'
7" Maple - S 55 W, 11.91'

STATE OF MICHIGAN
STEVEN P BYE
LAND SURVEYOR
No 35991
LICENSED LAND SURVEYOR

Signed by Steven P. Bye Date December 16, 19

Surveyor's Michigan License No. 35991

FORM APPROVED BY MICHIGAN STATE BOARD OF LAND SURVEYORS, JAN. 28, 1971
REVISED MAY 14, 1975
REVISED JAN., 1983

#398