

MAY 16 1997

COMMISSION

LAND CORNER RECORDATION CERTIFICATE
Filing Requirement of Act 74, Mich. P.A. 1970

For corners in

Leelanau
(County)

Located In:

Corner Code #

1. Public Land Survey

T29N R 12W D-3

2. Property Controlling in Section

S T R

3. Miscellaneous Property in Sec.

S T R

S T R

S T R

Barbara Kirt 01/09/97
Leelanau Reg of Deeds 9:52 am
BJK Feet 9.00
04B00002 F0166 Page 1 of 1

#469


Register of Deeds Stamp & File Number

4. Lot No. _____, Recorded Plat _____

5. Private Claims _____

I, David T. Rowe, in a field survey on Nov. 19, 1996 do hereby state that under requirements of P.A. 74, Michigan P.A. of 1970, the corner points mentioned in lines 1 and 2 above were in conformance with regulations and rules therefore as required in the current manual of survey instructions of the United States Department of the Interior, Bureau of Land Management or by a decree of a Court of Law and for that the corner points mentioned in lines 3, 4 and 5 above were in conformance with the rules of the Michigan Board of Land Surveyors or by a Decree of a Court of Law, established, re-established, monumented, recovered, found as expressed below:

NOTE: Not more than 2 corners, all in the same town and range, may be recorded on this certificate.

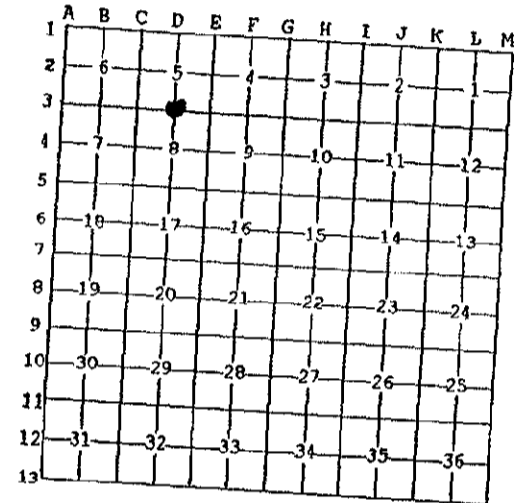

A. Description of original monument and accessories and/or subsequent restoration:

D-3: 1/4 corner common to Sections 5 and 8:
G.L.O. notes: Set 1/4 Post
Beech 10 - N77°W, 21 lks.
Beech 8 - S59°E, 26 lks.

Iron and cap set (L. Czubak 1974) Witnesses: 28" maple -- N50°W, 33.11'
10" maple - S75°W, 17.58'
8" maple - S10°W, 15.89'

B. Description of corner evidence found and/or method applied in restoring or reestablishing corner:

D-3: 1/4 corner common to Sections 5 and 8:
Iron with P.S. 12581 cap found.

APPROVED LAND CORNER
P.A. 345 OF 1990
LEELANAU COUNTY

DATE: 11-12-96

COUNTY REP. W. McO'Neil

C. Description of monument for corner and accessories established to perpetuate locating the position of the corner:

D-3: 1/4 corner common to Sections 5 and 8:
Iron with P.S. 12581 cap accepted as the best available evidence of the position of the original corner by the Leelanau County Peer Review Group, November 12, 1996, and replaced with a 3/4" i.d. galvanized iron pipe 3' long with a brass cap.

Witnesses: S03°E, 15.90' - Found spike in west face of a blazed 11" maple
S51°W, 17.61' - Found spike in north face of a blazed 14" maple
N75°W, 32.98' - Set spike in north face of a blazed 30" maple
S75°E, 28.79' - Set spike in northeast face of a twin 12" maple

Signed by David Rowe

Surveyor's Michigan License No. 11192

Date Dec 17, 1996



FORM APPROVED BY MICHIGAN STATE BOARD OF PROFESSIONAL SURVEYORS, JAN 26, 1983
REVISED MAY 14, 1985
REVISED JAN 1988
REVISED DEC 1995