

1993

COMMISSION

STATE OF MICHIGAN
COUNTY OF LEELANAU
RECEIVED FOR RECORD

1993 DEC 28 PM 4: 26

LAND CORNER RECORDATION CERTIFICATE
Filing Requirement of Act 74, Mich. P.A. 1970

For corners in

Leelanau
(County)

Located In:

Corner Code #

- | | | |
|------------------------------------|---------------------------|------------|
| 1. Public Land Survey | T <u>29N</u> R <u>12W</u> | <u>F-1</u> |
| | T _____ R _____ | _____ |
| | T _____ R _____ | _____ |
| | T _____ R _____ | _____ |
| 2. Property Controlling in Section | S _____ T _____ R _____ | _____ |
| | S _____ T _____ R _____ | _____ |
| 3. Miscellaneous Property in Sec. | S _____ T _____ R _____ | _____ |
| | S _____ T _____ R _____ | _____ |

Barbara Kirt
REGISTER OF DEEDS

FILE #338

LIBER 2 PAGE 35

Register of Deeds Stamp & File Number

4. Lot No. _____, Recorded Plat _____
5. Private Claims _____

	A	B	C	D	E	F	G	H	I	J	K	L	M
2	6	5	4	3	2	1							
3													
4	7	8	9	10	11	12							
5													
6	18	17	16	15	14	13							
7													
8	19	20	21	22	23	24							
9													
10	30	29	28	27	26	25							
11													
12	31	32	33	34	35	36							
13													

I, Steven P. Bye, in a field survey on December 9, 19 93, do hereby certify that under requirements of P.A. 74, Michigan P.A. of 1970, the corner points mentioned in lines 1 and 2 above were in conformance with regulations and rules therefore as required in the current manual of survey instructions of the United States Department of the Interior, Bureau of Land Management or by a decree of a Court of Law and/or that the corner points mentioned in lines 3, 4 and 5 above were in conformance with the rules of the Michigan Board of Land Surveyors or by a Decree of a Court of Law; established, re-established, monumented, re-monumented, recovered, found as expressed below:

NOTE: Not more than 4 corners, all in the same town and range, may be recorded on this certificate.

A. Description of original monument and accessories and/or subsequent restoration:

F-1: N 1/4 Section 4: G.L.O. "Set 1/4 section post"
Sugar 10 N 40 E, 34 links
Sugar 12 N 20W, 33 links


B. Description of corner evidence found and/or method applied in restoring or reestablishing corner:

F-1: N 1/4 Section 4: 1/2" iron bar with cap #13026 found on remnants of old E-W fenceline. This corner was set by Wm. B. Batzer Jr, and is a filed Land Corner recordation Certificate, file #75, "set 1/2" x 24" iron rod on fenceline E-W 60.21' west of South 1/4 corner of Section 33 - half way between NE section corner and probable location of NW section corner."

C. Description of monument for corner and accessories established to perpetuate locating the position of the corner:

F-1: N 1/4 Section 4: 1/2" iron bar with cap #13026 accepted by the Leelanau County Remonumentation Peer Review Group, November 29, 1993, and replaced with a 3/4" i.d. galvanized iron pipe 3' long with a brass cap.

- 14" Maple - West 15.29' (record)
- 11" Maple - S 28 W, 19.22' (record)
- 12" Maple - S 19 E, 6.80' (record)
- Iron rod with cap #13026 - East 60.21' (record)
- 20" diameter stump - East 1.88' (set spike)

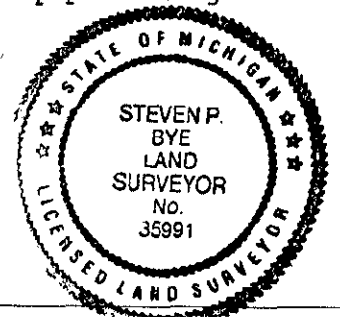

Signed by Steven P. Bye

Date 12-20-93

Surveyor's Michigan License No. 35991